


Give All Information Completely  
Make Required Affidavit  
Mail or Deliver Report to:  
Conservation Division  
State Corporation Commission  
212 No. Market  
Wichita, Kansas

WELL PLUGGING RECORD

Stafford County, Sec. 29 Twp. 21 Rge. (E) 13(W)

Location as "NE/CNW%SW%" or footage from lines NE SE NE  
Lease Owner Petroleum, Inc.  
Lease Name Essmiller A Well No. 2  
Office Address 352 North Broadway, Wichita, Kansas  
Character of Well (completed as Oil, Gas or Dry Hole) oil  
Date well completed 5-23 1951  
Application for plugging filed Jan. 8 1966  
Application for plugging approved 19  
Plugging commenced Jan. 31 1966  
Plugging completed Feb. 4 1966  
Reason for abandonment of well or producing formation depleted

NORTH

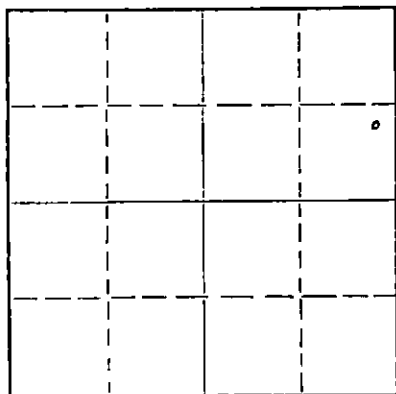

Locate well correctly on above  
Section Plat

If a producing well is abandoned, date of last production 19  
Was permission obtained from the Conservation Division or its agents before plugging was commenced? yes

Name of Conservation Agent who supervised plugging of this well Archie V. Elving  
Producing formation \_\_\_\_\_ Depth to top \_\_\_\_\_ Bottom \_\_\_\_\_ Total Depth of Well 3714 Feet  
Show depth and thickness of all water, oil and gas formations.

OIL, GAS OR WATER RECORDS

CASING RECORD

FORMATION	CONTENT	FROM	TO	SIZE	PUT IN	PULLED OUT
		0	356	8 5/8"	356	none
		0	3709	5 1/2"	3709	2747.10

Describe in detail the manner in which the well was plugged, indicating where the mud fluid was placed and the method or methods used in introducing it into the hole. If cement or other plugs were used, state the character of same and depth placed, from \_\_\_\_\_ feet to \_\_\_\_\_ feet for each plug set.

Pushed plug to 3370', set 10' rock bridge and dumped 5 sacks of cement.

Pushed plug to 275', set 15' rock bridge and dumped 10 gallons of sand. Mixed 3 sacks of cement and 4 gallons of calcium chloride and dumped at 260'. Bailed hole down and dumped 22 sacks of cement. Filled hole with mud to 40', set 10' rock bridge and capped hole with 10 sacks of cement.

RECEIVED  
STATE CORPORATION COMMISSION

FEB 24 1966

CONSERVATION DIVISION  
Wichita, Kansas

(If additional description is necessary, use BACK of this sheet)  
Name of Plugging Contractor Pipe Pullers, Inc.  
Address Box 486, Ellinwood, Kansas

STATE OF Kansas, COUNTY OF Barton, ss.  
Dean Wells (employee of owner) or (~~owner or operator~~) of the above-described well, being first duly sworn on oath, says: That I have knowledge of the facts, statements, and matters herein contained and the log of the above-described well as filed and that the same are true and correct. So help me God.

(Signature) Dean Wells  
Ellinwood, Kansas  
(Address)

SUBSCRIBED AND SWORN TO before me this 21 day of February, 1966

My commission expires July 7, 1968 [Signature] Notary Public.

15.185.01765.0000

COPY


WELL LOG BUREAU -- KANSAS GEOLOGICAL SOCIETY  
508 East Murdock Wichita, Kansas

Company - CITIES SERVICE OIL CO.  
Farm - E. Smiller No. 2

SEC. 29 T. 21 R. 13W  
NE SE NE  
990' N & 330' W of E 1/4 corner

Total Depth. 3714  
Comm. 5-6-51 Comp. 5-23-51  
Shot or Treated. 500 gals acid 5-24-51  
Contractor. Barbour Drilling Company  
Issued. 9-8-51

County. Stafford  
KANSAS

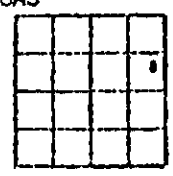

Elevation. 1906

Production. Physical Potential  
336 oil, no water

CASING:

8 5/8" 356' cem w/250 sp.  
5 1/2" 3709' cem w/150 sp.

Figures Indicate Bottom of Formations.

surface sand, shells	110
sand, shale	190
iron, shale	210
sand	280
shale, iron	335
red bed	787
anhydrite	805
redbed, shale, shells	1215
shale	1295
shale, shells	1610
lime, shale	1895
lime	1925
shale, lime	2125
lime	2145
shale, lime	2370
shale	2525
shale, lime	2760
shale, shells	2910
shale, lime	3145
lime	3255
shale, lime	3365
lime	3650
lime cherty, sand, & shale	3673
shale, sand	3691
shale, lime, chert	3711
lime	3713
3713 RTD = 3710 SLM	
lime	3714
Total Depth	

Tops: Corr.	
Lansing	3356
Conglomerate	3608
Viola	3615
Simpson	3655
Arbuckle	3708
Penetration	6

Fillup: 435' oil in 10 hrs.  
40 mins.

RECEIVED  
STATE CORPORATION COMMISSION

FEB 24 1965

CONSERVATION DIVISION  
Wichita, Kansas