

STATE OF KANSAS
STATE CORPORATION COMMISSION


Form CP-4

WELL PLUGGING RECORD

Give All Information Completely
Make Required Affidavit
Mail or Deliver Report to:
Conservation Division
State Corporation Commission
212 No. Market
Wichita, Kansas

Stafford County, Sec. 29 Twp. 21 Rge. (E) 13 (W)

Location as "NE/CNW&SW&" or footage from lines SE SE NE
Lease Owner Petroleum, Inc.
Lease Name Essmiller A Well No. 1
Office Address 352 North Broadway, Wichita, Kansas
Character of Well (completed as Oil, Gas or Dry Hole) oil
Date well completed March 31 1951
Application for plugging filed January 8 1966
Application for plugging approved 19
Plugging commenced January 22 1966
Plugging completed February 10 1966
Reason for abandonment of well or producing formation depleted

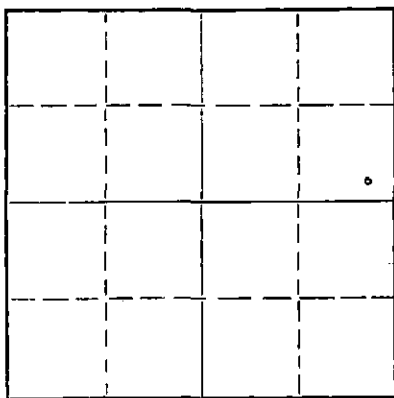

Locate well correctly on above
Section Plat

If a producing well is abandoned, date of last production 19
Was permission obtained from the Conservation Division or its agents before plugging was commenced? yes

Name of Conservation Agent who supervised plugging of this well Archie V. Elving
Producing formation Depth to top Bottom Total Depth of Well 3715 Feet
Show depth and thickness of all water, oil and gas formations.

OIL, GAS OR WATER RECORDS

CASING RECORD

FORMATION	CONTENT	FROM	TO	SIZE	PUT IN	PULLED OUT
		0	354	8 5/8"	354'	none
		0	3708	5 1/2"	3708'	2506.10

Describe in detail the manner in which the well was plugged, indicating where the mud fluid was placed and the method or methods used in introducing it into the hole. If cement or other plugs were used, state the character of same and depth placed, from feet to feet for each plug set.

Pushed plug to 3370', set 50' rock bridge and dumped 5 sacks of cement.

Pushed plug to 280'. Dumped 10 feet of rock and 10 gallons of sand. Mix 6 sacks of cement and dump at 267'. Bailed hole down. Dumped 19 sacks of cement. Filled hole with mud to 40', set 10' rock bridge and capped hole with 10 sacks of cement.

RECEIVED
STATE CORPORATION COMMISSION

FEB 24 1966 2-24-1966

CONSERVATION DIVISION
WICHITA, KANSAS

(If additional description is necessary, use BACK of this sheet)
Name of Plugging Contractor Pipe Pullers, Inc.
Address Box 486, Ellinwood, Kansas

STATE OF Kansas, COUNTY OF Barton, ss.
Dean Wells (employee of owner) or (owner or operator) of the above-described well, being first duly sworn on oath, says: That I have knowledge of the facts, statements, and matters herein contained and the log of the above-described well as filed and that the same are true and correct. So help me God.

(Signature) Dean Wells

Ellinwood, Kansas


SUBSCRIBED AND SWORN TO before me this 21 day of February, 1966

(Address)
J. Hader

My commission expires July 7, 1968

Notary Public.

COPY

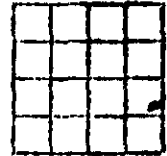WELL LOG BUREAU - KANSAS GEOLOGICAL SOCIETY
508 East Murdock, Wichita, KansasCompany - CITIES SERVICE OIL COMPANY
Farm - Essemiller No. 1SEC. 29 T. 21 R. 13W
SE 9E NE
330' N & 330' W of E $\frac{1}{2}$ cornerTotal Depth. 3715
Comm. 3-15-51 Comp. 3-31-51
Shot or Treated.
Contractor. Holm Drilling Co.
Issued. 6-23-51County. Stafford
KANSASCASTING:
8 5/8" 354' cem w/250 sx
5 1/2" 3713' cem w/150 sx

Elevation. 1925

Production. Phy. Pot. 379 bbls,
24 water

Figures Indicate Bottom of Formations.

sand & clay	110
shells, shale	355
red bed	750
lime	790
shale, shells	1730
lime	1865
lime & shale	2025
lime	2085
shale & shells	2475
lime & shale	2660
shale & shells	2820
shale & lime	2895
lime, shale	3140
lime	3200
shale & lime	3275
lime	3620
lime & chert	3650
lime	RTD 3714
3714 RTD - 3709 SLM	
lime	3715
Total Depth	

Tops: corr.	
Lansing	3361
Conglomerate	3607
Viola	3614
Simpson Shale	3653
Arbuckle	3707
Penetration	8

Fillup:

90' oil in 30 mins. @ 3710
 160' oil in 1 hr. 5 min. @ 3710
 1825' oil in 3 hrs @ 3715
 2015' oil in 3 $\frac{1}{2}$ hrs @ 3715
 3218' oil in 23 hrs @ 3715

4-2-51 Pmped 164 oil, no wtr.
in 9 3/4 hrs.Drill Stem Test: 3384-3413,
recovered 810' fluid (60'
oil-cut mud, 60' muddy oil
and 690' oil) in 30 mins.;
10 min. BHP 970#.RECEIVED
STATE CORPORATION COMMISSION

FEB 24 1966

CONSERVATION DIVISION
Wichita, Kansas