


WELL PLUGGING RECORD

Give Information Completely
Map Required Affidavit
or Deliver Report to:
Conservation Division
State Corporation Commission
211 No. Broadway
Wichita, Kansas

Stafford County. Sec. 29 Twp. 21 Rge. 13 (X) W (W)
Location as "NE/CNW%SW%" or footage from lines SE NE SW
Lease Owner Petroleum, Inc.
Lease Name Keller "B" Well No. 1
Office Address Route 2, Great Bend, Kansas
Character of Well (completed as Oil, Gas or Dry Hole) Oil
Date well completed April 19 1950
Application for plugging filed Sept. 18 1958
Application for plugging approved Sept. 19 1958
Plugging commenced Oct. 4 1958
Plugging completed Oct. 6 1958
Reason for abandonment of well or producing formation Depletion of producible zones

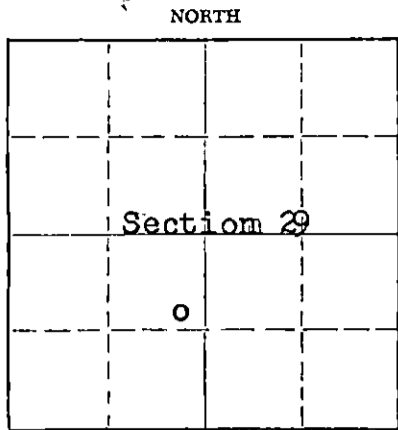

Locate well correctly on above Section Plat

If a producing well is abandoned, date of last production May 23 1958
Was permission obtained from the Conservation Division or its agents before plugging was commenced? Yes

Name of Conservation Agent who supervised plugging of this well Frank Broadfoot.
Producing formation Kansas City Depth to top 3377' Bottom _____ Total Depth of Well 3782 Feet
Show depth and thickness of all water, oil and gas formations.

OIL, GAS OR WATER RECORDS

CASING RECORD

FORMATION	CONTENT	FROM	TO	SIZE	PUT IN	PULLED OUT
				8 5/8"	246'	None
				5 1/2"	3776'	2500'
<u>Kansas City</u>	<u>Little oil and water</u>	<u>3446'</u>	<u>3452'</u>			

Describe in detail the manner in which the well was plugged, indicating where the mud fluid was placed and the method or methods used in introducing it into the hole. If cement or other plugs were used, state the character of same and depth placed, from _____ feet to _____ feet for each plug set.

(Plugged back to 3480')

Filled hole with crushed rock from 3480' to 3440' followed by 5 sacks cement. Mixed and pumped in 15 sacks gel followed by a plug and 75 sacks cement to base of well cellar.

(If additional description is necessary, use BACK of this sheet)

Name of Plugging Contractor Southwest Casing Pulling, Inc.
Address Great Bend, Kansas

STATE OF Kansas, COUNTY OF Barton , ss.
Don Searle (employee of owner) or (~~owner or operator~~) of the above-described well, being first duly sworn on oath, says: That I have knowledge of the facts, statements, and matters herein contained and the log of the above-described well as filed and that the same are true and correct. So help me God.

(Signature) Don Searle
Route 2, Great Bend, Kansas
(Address)

SUBSCRIBED AND SWORN TO before me this 7th day of October 1958

My commission expires July 11, 1960

Del. A. R. ...
STATE CORPORATION COMMISSION (Notary Public)

PLUGGING 00 10 1958
FILE SFC 29 T 21 DR (3w)
BOOK PAGE 130 LINE 31
10-10-1958

WELL LOG KELLER 'B' 1

Petroleum, Inc., Lease Owner

Section 29, Twp. 21S, Rge. 13W

Drillers, Inc., Contractor

Location: SE NE SW

Rotary Total Depth: 3782'

County: Stafford, Kansas

Commenced: April 1, 1950
Completed: April 13, 1950

Production: Arbuckle

Elevation: 1908 D.F.

Casing: 259' of 8 5/8"
3786.57 of 5 1/2"

Figures below indicate bottom of formation:

130 Sand	3685 Chert-Viola
200 Sand & Gravel	3695 Shale
246 Shale & Shells	3748 Lime
350 Sand & Shale	
685 Red Bed	3782 Rotary Total Depth
820 Anhydrite	
1435 Shale & Shells	
1775 Lime	<u>Tops</u>
1920 Lime & Shale	790 Anhydrite
2025 Lime	3238 Heebner
2180 Lime & Shale	3259 Toronto
2580 Shale & Shells	3285 B. O.
2975 Shale & Lime	3363 Brown Lime
3075 Lime	3377 Lansing
3120 Lime & Shale	3624 P.B.C.
3194 Lime	3647 Viola
3336 Lime & Shale	3691 Simpson
3415 Lime	3741 Arbuckle
3576 Porows Lime	
3578 Lime	
3629 Lime & Shale	
3654 Conglomerate	

I hereby certify that this is a true and correct log of the above mentioned well.

PETROLEUM, INC.

Eric H. Jager
Eric H. Jager

STATE OF KANSAS
SS.
SEDGWICK COUNTY

PLUGGING
FILE SEC 29 T 21 R 13W
BOOK PAGE 130 LINE 31

Subscribed to and sworn to before me, a Notary Public in said County and State this 20th day of April, 1950.

Margorie Bradshaw
Notary Public

My commission expires: October 27, 1952.