


WELL PLUGGING RECORD

Give All Information Completely
Make Required Affidavit
Mail or Deliver Report to:
Conservation Division
State Corporation Commission
800 Bitting Building
Wichita, Kansas

McPherson County. Sec. 28 Twp. 21 Rge. 3W ~~(E)XXXXXX~~
Location as "NE/CNW/SW" or footage from lines SE NW SW
Lease Owner John Linds Oil, Inc.
Lease Name Schroeder Well No. 1
Office Address 701 Bule Bldg, 321 E. William, Wichita 2, Kansas
Character of Well (completed as Oil, Gas or Dry Hole) Dry Hole
Date well completed 8-18-54
Application for plugging filed February 16 19 55
Application for plugging approved " 16 19 55
Plugging commenced " 17 19 55
Plugging completed " 25 19 55
Reason for abandonment of well or producing formation Dry

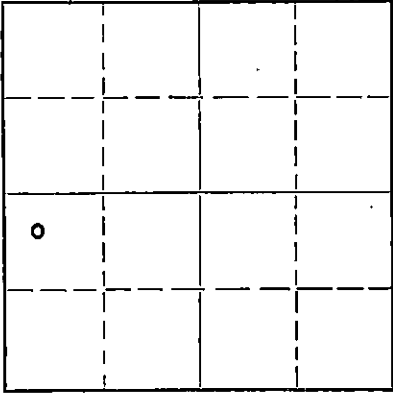

Locate well correctly on above
Section Plat

If a producing well is abandoned, date of last production 19
Was permission obtained from the Conservation Division or its agents before plugging was commenced? _____

Name of Conservation Agent who supervised plugging of this well Fuel Durkee
Producing formation _____ Depth to top _____ Bottom _____ Total Depth of Well _____ Feet
Show depth and thickness of all water, oil and gas formations.

OIL, GAS OR WATER RECORDS				CASING RECORD		
FORMATION	CONTENT	FROM	TO	SIZE	PUT IN	PULLED OUT
				8-5/8"	204'	None
				5-1/2"	3222'	2640'

Describe in detail the manner in which the well was plugged, indicating where the mud fluid was placed and the method or methods used in introducing it into the hole. If cement or other plugs were used, state the character of same and depth placed, from _____ feet to _____ feet for each plug set.

Hole was plugged back to 3135' and Lane-Wells Plug set.
Plugged back to 3100' with Rock Ram 1 sack Cal Seal and 6 sacks cement.
Mudded hole to 300'. Set 10' Rock Bridge ran 30 sacks cement. Welded cap on same.

(If additional description is necessary, use BACK of this sheet)
Name of Plugging Contractor R & D Casing Pulling Co.
Address Ellinwood, Kansas

STATE OF KANSAS COUNTY OF SEDGWICK, ss.
Fred Moore (employee of owner) or (owner/operator) of the above-described well, being first duly sworn on oath, says: That I have knowledge of the facts, statements, and matters herein contained and the log of the above-described well as filed and that the same are true and correct. So help me God.

(Signature) Fred Moore

(Address) _____

SUBSCRIBED AND SWORN TO before me this 8th day of March 19 55

My commission expires March 25, 1956

Catherine Jancy Notary Public.

RECEIVED
STATE CORPORATION COMMISSION

MAR 27 1955

CONSERVATION DIVISION

3-9-1955

PLUGGING
FILE DEC 21 T 21 R 3W
BOOK PAGE 97 LINE 36

