


WELL PLUGGING RECORD

Give All Information Completely
Make Required Affidavit
Mail or Deliver Report to:
Conservation Division
State Corporation Commission
800 Bldg Building
Wichita, Kansas

NORTH

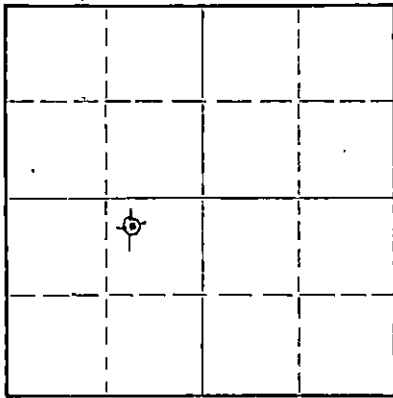

Locate well correctly on above Section Plat

McPherson County, Sec. 28 Twp. 21S Rge. 3 (E) (W)

Location as "NE/CNW&SW" or footage from lines NW NE SW
Lease Owner T. T. Ellsworth & Braden Drilling Company
Lease Name Schroeder Well No. 2
Office Address 814 Union National Bank Building, Wichita, Kansas
Character of Well (completed as Oil, Gas or Dry Hole) dry
Date well completed February 16, 1955
Application for plugging filed February 24, 1955
Application for plugging approved February 24, 1955
Plugging commenced February 28, 1955
Plugging completed March 7, 1955
Reason for abandonment of well or producing formation dry hole

If a producing well is abandoned, date of last production _____ 19____
Was permission obtained from the Conservation Division or its agents before plugging was commenced? yes

Name of Conservation Agent who supervised plugging of this well Mr. Ruel Durkee
Producing formation _____ Depth to top _____ Bottom _____ Total Depth of Well 3111 Feet
Show depth and thickness of all water, oil and gas formations.

OIL, GAS OR WATER RECORDS

CASING RECORD

| FORMATION | CONTENT | FROM | TO | SIZE | PUT IN | PULLED OUT |
|-----------|---------|------|----|-------|--------|------------|
| | | | | 8-5/8 | 172' | none |
| | | | | 5-1/2 | 3105 | 2514 |
| | | | | | | |
| | | | | | | |
| | | | | | | |
| | | | | | | |
| | | | | | | |

Describe in detail the manner in which the well was plugged, indicating where the mud fluid was placed and the method or methods used in introducing it into the hole. If cement or other plugs were used, state the character of same and depth placed, from _____ feet to _____ feet for each plug set.

Plugged bottom of the hole to 3100' with rock - ran 6 sacks cement - mudded hole to 310' - set bridge @ 310' - put in 10' rock - ran 30 sacks cement - mudded hole to 35' - ran 5 sacks cement.

MAR 26 1955

CONSERVATION DIVISION
Wichita, Kansas

3-26-1955

(If additional description is necessary, use BACK of this sheet)
Name of Plugging Contractor R & D Casing Pulling Company (Permit #236)
Address Box 569, Ellinwood, Kansas

STATE OF Kansas, COUNTY OF Sedgwick, ss.
Ray O. Braden (employee of owner) or (owner or operator) of the above-described well, being first duly sworn on oath, says: That I have knowledge of the facts, statements, and matters herein contained and the log of the above-described well as filed and that the same are true and correct. So help me God.

(Signature) Ray O. Braden
Partner
814 Union National Bank Bldg.
(Address)

SUBSCRIBED AND SWORN to before me this 25th day of March, 1955

Norma Reiberg Notary Public.

My commission expires April 29, 1957

PLUGGING
FILE SEC. 28 TWP. 21 RGE. 3
BOOK PAGE 99 LINE 24

Schroeder #2

Operator: T. T. Ellsworth & Braden Drilling Co

23-210-3W

Contractor: Braden Drilling Co.

T17 NE SW

Wofferson County, Kansas

Test Commenced: 1-21-55

Elevation: 1466 D. P.

Test Completed: 2-2-55

Casing Record:

8 5/8" casing set @ 172' with 150 sacks cement.
5 1/2" casing set @ 3105' with 75 sacks cement.

| | |
|--------------------|------------------|
| Clay, Shale & Sand | 105 |
| Shale & Shells | 400 |
| Shale | 432 |
| Anhydrite | 573 |
| Lime & Shale | 830 |
| Lime | 1150 |
| Broken Lime | 1255 |
| Shale & Shells | 1545 |
| Lime & Shale | 1630 |
| Lime | 1930 |
| Lime & Shale | 2038 |
| Lime | 2105 |
| Lime & Shale | 2365 |
| Lime | 2855 |
| Lime & Shale | 3110 T. D. R. D. |

STATE OF KANSAS }
COUNTY OF SEDGWICK } SS

I hereby certify that the above information is true and correct as revealed by the records of the Braden Drilling Co.

Norma E. Patrick

Subscribed and sworn to before me this 7th day of February, 1955

Norma Richey
Notary Public

My commission expires: April 29, 1957

PLUGGING
WELL SEC 28 Y 21 R 3W
BLOCK PAUL 99 LINE 24