


WELL PLUGGING RECORD

Give All Information Completely
Make Required Affidavit
Mail or Delivery Report to:
Conservation Division
State Corporation Commission
800 Bittling Building
Wichita, Kansas

McPherson County, Sec. 28 Twp. 21 Rge. 3 (W)

Location as "NE/CNW/SE" or footage from lines C W/2 NW SE
Lease Owner KEWANEE OIL COMPANY
Lease Name MARTA Well No. 1
Office Address BOX 589, EL DORADO, KANSAS
Character of Well (completed as Oil, Gas or Dry Hole) DRY
Date well completed XXX 12-8-54 19
Application for plugging filed 12-8-54 19
Application for plugging approved 12-8-54 19
Plugging commenced 12-8-54 19
Plugging completed 12-8-54 19
Reason for abandonment of well or producing formation Dry Hole

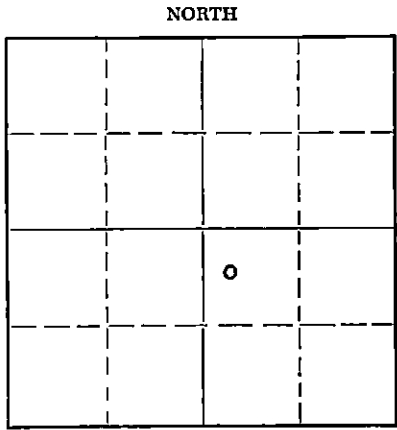

Locate well correctly on above Section Plat

If a producing well is abandoned, date of last production _____ 19____
Was permission obtained from the Conservation Division or its agents before plugging was commenced? Yes

Name of Conservation Agent who supervised plugging of this well R. F. DURKEE
Producing formation NONE Depth to top _____ Bottom _____ Total Depth of Well 3200 Feet
Show depth and thickness of all water, oil and gas formations.

OIL, GAS OR WATER RECORDS

CASING RECORD

FORMATION	CONTENT	FROM	TO	SIZE	PUT IN	PULLED OUT
				10-3/4"	320.60	None

Describe in detail the manner in which the well was plugged, indicating where the mud fluid was placed and the method or methods used in introducing it into the hole. If cement or other plugs were used, state the character of same and depth placed, from _____ feet to _____ feet for each plug set.

Circulated mud to 315' and set stone bridge from 315' to 310' then 20 sacks cement from 310' to 270', mud from 270' to 11' then 5 sacks cement in top of surface pipe.

(If additional description is necessary, use BACK of this sheet)

Name of Plugging Contractor REX & MORRIS DRILLING COMPANY
Address EL DORADO, KANSAS

STATE OF KANSAS, COUNTY OF BUTLER, ss.
PAUL G. ARNOLD (employee of owner) or (owner or operator) of the above-described well, being first duly sworn on oath, says: That I have knowledge of the facts, statements, and matters herein contained and the log of the above-described well as filed and that the same are true and correct. So help me God.

(Signature) Paul G. Arnold
P.O. BOX 589, EL DORADO, KANSAS
(Address)

SUBSCRIBED AND SWORN to before me this 21 day of DECEMBER, 19 54

My commission expires 11-29-58

Nigel L. Tompkins
Notary Public.

PLUGGING
FILE SEC 28 T 21 R 3W
BOOK PAGE 82 LINE 4

12-22-1954

KEWAHNE OIL COMPANY

WELL RECORD: Maria # 1

Elevation: 1456' C.M.

LOCATION: Located 660' from North line and 330' from West line of SE/4 of Sec. 28, T-21-S, R-3-W, McPherson County, Kansas.

TOTAL DEPTH: 3200'

COMMENCED DRILLING: 11-26-54

COMPLETED DRILLING: 12-3-54

COMPLETION DATE: 12-3-54

DRILLING CONTRACTOR: Rex & Morris Drilling Co.

INITIAL PRODUCTION: Dry and Abandoned

DELMER L. POWERS FORMATION TOPS

2185'	(-727)	Douglas "Sand"
2419'	(-963)	Kansas City Lims
3084'	(-1628)	Cherty Conglomerate
3095'	(-1639)	Mississippi "Chat" Limestone
3200'	(-1744)	Total Depth

CASING RECORD

10-3/4" - Casing set at 320.60' C.M. and cemented with 225 sacks of cement.

FORMATION RECORD

0-4	Cellar
35	Soil and clay
150	Sand and gravel
435	Shale and lime
690	Lime and shale
760	Shale and lime
905	Lime and shale
1830	Shale and lime
1940	Lime
2183	Lime
2274	Douglas Sand
2363	Shale
2419	Kansas City Lime
2680	Lime
2745	Lime and shale
2826	Lime
2908	Lime and shale
3051	Shale and lime
3084	Shale
3095	Conglomerate
3095	Top Miss. Chat
3133	Chert w/little shale - spotted stain.
3143.5	Lime and chert - spotted stain.
3148	Chert w/little lime
3152	Dolomite - some stain but very tight
3196	Chert and Dolomite
3200	Chert
3200	TOTAL DEPTH

SLOPE TESTS

<u>DEPTH</u>	<u>DEVIATION</u>
300'	0°
500'	10
1000'	10
1500'	0°
2000'	0°
2500'	10
3050'	10

PLUGGING
 FILE SEC 28 T 21 R 3 W
 MARK PAGE 12 LINE 4