


WELL PLUGGING RECORD

Give All Information Completely
Make Required Affidavit
Mail or Deliver Report to:
Conservation Division
State Corporation Commission
800 Bittling Building
Wichita, Kansas

NORTH

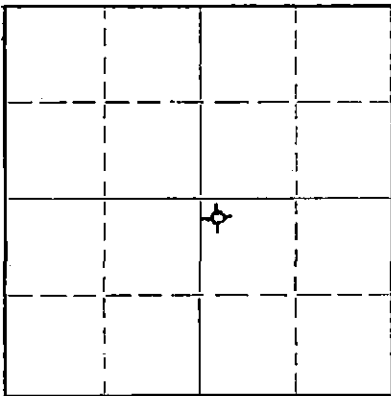

Locate well correctly on above
Section Flat

McPherson

County. Sec. 28 Twp. 21 Rge. 3 (E) (West)

Location as "NE/CNW/SW" or footage from lines. NW NW SE

Lease Owner. Ben F. Brack Oil Co. Inc.

Lease Name. Schroeder

Well No. 1

Office Address. 309-10 Brown Bldg. Wichita, Kansas

Character of Well (completed as Oil, Gas or Dry Hole) Dry Hole

Date well completed. 4-30 19 49

Application for plugging filed. 5-9 19 49

Application for plugging approved. 5-9 19 49

Plugging commenced. 5-10 19 49

Plugging completed. 5-11 19 49

Reason for abandonment of well or producing formation. Dry Hole

If a producing well is abandoned, date of last production. 19

Was permission obtained from the Conservation Division or its agents before plugging was commenced? Yes

Name of Conservation Agent who supervised plugging of this well. Rul Durkey

Producing formation. Chat Depth to top. 3098' Bottom. 3260' Total Depth of Well. 3556 Feet

Show depth and thickness of all water, oil and gas formations.

OIL, GAS OR WATER RECORDS

CASING RECORD

Formation	Content	From	To	Size	Put In	Pulled Out
Chat	dry	3098	3260	5 1/2	3102	2730
Hunton	dry	3400	3518	0	0	0
Viola	dry	3518	3556	0	0	0

Describe in detail the manner in which the well was plugged, indicating where the mud fluid was placed and the method or methods used in introducing it into the hole. If cement or other plugs were used, state the character of same and depth placed, from 3556 feet to 3145 feet for each plug set. Cement thru Drill Pipe, By Halliburton- 135 Sax

Filled Hole with crushed rock to 3102- Dump 6 Sax cement with dump bailer. Shot off at 2700' pulled pipe and mudded hole with heavy mud to 300' set bridging plug and dumped 15' Sax cement - mudded hole up to 15' set plug and dumped 6 sax cement on top of same

RECEIVED
Conservation Div.
MAY 27 1949
STATE CORPORATION
COMMISSION
KANSAS

(If additional description is necessary, use BACK of this sheet)

Correspondence regarding this well should be addressed to. Ben F. Brack Oil Co. Inc.
Address. 309-10 Brown Bldg, Wichita, Kansas

STATE OF Kansas, COUNTY OF Sedgwick, ss.
W. J. Hall (employee of owner) or (owner or operator) of the above-described well,
being first duly sworn on oath, says: That I have knowledge of the facts, statements, and matters herein contained and the log of the above-described well as filed and that the same are true and correct. So help me God.


(Signature) W. J. Hall
Yt Bend, Kansas (Address)

SUBSCRIBED AND SWORN to before me this 21 st day of May, 19 49

Public Notary
Notary Public.

My commission expires November 5, 1951

22-5133-s 9-48-10M

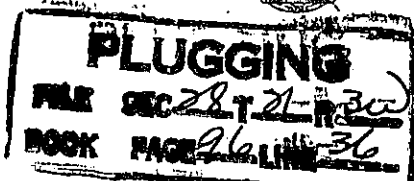

Ben F. Brack Oil Company, Inc.
310 Brown Building
Wichita, Kansas

Schroeder #1 - NW NW SE, Section 28, T. 21 S., R. 3 W.
McPherson County, Kansas

TOTAL DEPTH 3556'
Comm: 3-28-49 Comp: 4-15-49

Cellar	5'
Sand, Clay & Shells	160
Sand and Shale	220
Shells and Shale	420
Shale and Sand	580
Shale	680
Anhydrite	720
Shale and Shells	800
Shale & Shells	950
Shale	1210
Shale & Shells	1460
Shale & Shells	1635
Shale	1790
Shale & Lime	1880
Lime & Shale	1980
Lime & Shale	2050
Lime & Shale	2125
Lime & Shale	2215
Shale	2365
Lime & Shale	2415
Lime & Shale	2490
Shale & Lime	2540
Broken Lime	2575
Lime	2613
Lime	2668
Lime & Shale	2715
Lime & Shale	2759
Lime & Shale	2805
Lime & Shale	2880
Lime & Shale	2940
Lime & Shale	3005
Lime & Shale	3065
Shale & Lime	3105
Chert	3120
Chert	3145
Chat	3165
Chat	3200
Chat	3213
Lime	3236
Lime	3246
Lime	3278
Shale	3303
Shale, Lime & Shells	3344
Shale	3383
Shale & Lime	3420
Lime	3455
Shale	3477
Shale	3508
Shale	3518
Lime	3540
Lime & Sand	3556
Total Depth	3556

RECEIVED

Conservation-Div.

MAY 27 1949

STATE CORPORATION
COMMISSION
KANSAS

To the best of my knowledge the
above is a true and correct record
of the formations and depths at
which found.

BEN F. BRACK OIL COMPANY, INC.

By Ben F. Brack

Dated: 4-19-49

Witness: Pauline Sandrich

