


WELL PLUGGING RECORD

Give All Information Completely
Make Required Affidavit
Mail or Deliver Report to:
Conservation Division
State Corporation Commission
211 No. Broadway
Wichita, Kansas

Stafford County. Sec. 8 Twp. 21S Rge. 11W (~~28~~) (W)
Location as "NE/CNW/SW" or footage from lines NW NW SW
Lease Owner Duke Drilling Company
Lease Name Keeler Well No. 1
Office Address Box 123, Great Bend, Kansas
Character of Well (completed as Oil, Gas or Dry Hole) Oil
Date well completed September 9 19 57
Application for plugging filed January 20 19 58
Application for plugging approved January 21 19 58
Plugging commenced February 1 19 58
Plugging completed February 5 19 58
Reason for abandonment of well or producing formation Unprofitable to operate

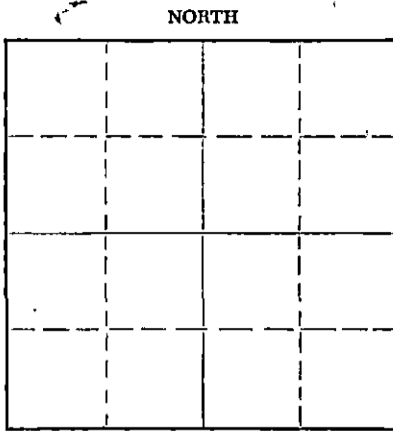

Locate well correctly on above Section Plat

If a producing well is abandoned, date of last production December 23 19 57
Was permission obtained from the Conservation Division or its agents before plugging was commenced? Yes

Name of Conservation Agent who supervised plugging of this well Frank Broadfoot
Producing formation Arbuckle Depth to top 3425' Bottom _____ Total Depth of Well 3455 Feet
Show depth and thickness of all water, oil and gas formations.

OIL, GAS OR WATER RECORDS

CASING RECORD

FORMATION	CONTENT	FROM	TO	SIZE	PUT IN	PULLED OUT
		0	258	8 5/8"	258'	None
			3449	5 1/2"	3449	2744.70'

Describe in detail the manner in which the well was plugged, indicating where the mud fluid was placed and the method or methods used in introducing it into the hole. If cement or other plugs were used, state the character of same and depth placed, from _____ feet to _____ feet for each plug set.

Plugged back with sand from 3444' to 3425'. Dumped 5 sacks cement from 3425'
to 3385'. Pull casing. Mud to 245'. Set 5' rock bridge from 245' to 240'.
Dump 20 sacks cement from 240' to 180'. Mud from 180' to 35'. Set 5' rock
bridge from 35' to 30'. Dump 10 sacks cement from 30' to base collar.

RECEIVED
STATE CORPORATION COMMISSION

FEB 12 1958

CONSERVATION DIVISION
Wichita, Kansas

(If additional description is necessary, use BACK of this sheet)

Name of Plugging Contractor Ace Pipe Pulling Company
Address Box 304, Great Bend, Kansas

STATE OF Kansas COUNTY OF Barton ss.
Cecil M. Olson (employee of owner) or (~~owner~~) of the above-described well, being first duly sworn on oath, says: That I have knowledge of the facts, statements, and matters herein contained and the log of the above-described well as filed and that the same are true and correct. So help me God.

(Signature) Cecil M. Olson

Box 123, Great Bend, Kansas
(Address)

SUBSCRIBED AND SWORN to before me this 11th day of February, 19 58

Chas. E. Stinson
Notary Public.

My commission expires June 24, 1959

PLUGGING
FILE SEC 8 T. 21R 11W
BOOK PAGE 77 LINE 20

15.185.13190.0000

WELL LOG

Date Started: August 30, 1957
Date Completed: September 8, 1957

Keeler No. 1
NW NW SW
Section 8-21S-11W
Stafford County, Kansas

Elevation	1801'	K.B.
Anhydrite	573'	(-1228)
Heebner	3001'	(-1200)
Brown Lime	3125'	(-1324)
Lansing	3144'	(-1343)
Conglomerate	3395'	(-1594)
Arbuckle	3425'	(-1654)
R.T.D.	3455'	(-1654)

8 5/8" set at 258'
5 1/2" set at 3449'

0'	- 212'	Surface Sand
212'	- 220'	Red Rock
220'	- 230'	Sand
230'	- 380'	Red Bed
380'	- 573'	Red Bed
573'	- 583'	Anhydrite
583'	- 820'	Shale and Red Bed
820'	- 1150'	Shale and Shell
1150'	- 1305'	Salt and Shale
1305'	- 1555'	Shale and Shells
1555'	- 1740'	Shale and Shells
1740'	- 2045'	Lime and Shale
2045'	- 2595'	Lime and Shale
2595'	- 2700'	Lime and Shale
2700'	- 3001'	Lime
3001'	- 3090'	Heebner
3090'	- 3144'	Lime
3144'	- 3175'	Lansing
3175'	- 3310'	Lime
3310'	- 3425'	Lime
3425'	- 3455'	Arbuckle
3455'		R.T.D.

STATE CORPORATION COMMISSION
JAN 21 1958
CONSERVATION DIVISION
Wichita, Kansas

AFFIDAVIT

State of Kansas County of Barton

I, Cecil M. Olson, employee of the owner, do swear that the statements and matter herein contained are true to the best of my knowledge.

THE DUKE DRILLING COMPANY

BY: C Olson

Subscribed and sworn before me this 24th day of September, 1957.

Chas E Stinson
NOTARY PUBLIC

My commission expires: June 24, 1959.

PLUGGING
FILE SEC. 8 T. 21 R. 11 W
BOOK PAGE 77 LINE 20