


STATE OF KANSAS
STATE CORPORATION COMMISSION

Form CP-4

WELL PLUGGING RECORD

Give All Information Completely
Make Required Affidavit
Mail or Deliver Report to:
Conservation Division
State Corporation Commission
P. O. Box 17027
Wichita, Kansas 67217
NORTH

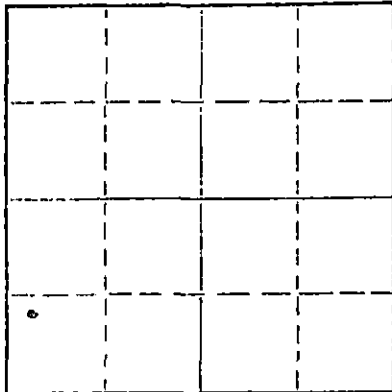

Locate well correctly on above
Section Plat

Stafford County, Sec. 8 Twp. 21 Rge. 11 (E) (W)
Location as "NE/CNW/SW" or footage from lines. NW SW SW
Lease Owner F. G. Holl
Lease Name Keeler "B" Well No. 1
Office Address 6427 E. Kellogg, Wichita, Kansas 67207
Character of Well (completed as Oil, Gas or Dry Hole) OWWO
Date well completed _____ 19____
Application for plugging filed Feb. 18 19 72
Application for plugging approved _____ 19____
Plugging commenced Feb. 24 19 72
Plugging completed Feb. 29 19 72
Reason for abandonment of well or producing formation depleted
If a producing well is abandoned, date of last production _____ 19____
Was permission obtained from the Conservation Division or its agents before plugging was commenced? yes

Name of Conservation Agent who supervised plugging of this well G. R. Biberstein
Producing formation _____ Depth to top _____ Bottom _____ Total Depth of Well 3469 Feet
Show depth and thickness of all water, oil and gas formations.

OIL, GAS OR WATER RECORDS

CASING RECORD

FORMATION	CONTENT	FROM	TO	SIZE	PUT IN	PULLED OUT
		0	293'	8 5/8"	293'	none
		0	3469'	4 1/2"	3469'	2607.62

Describe in detail the manner in which the well was plugged, indicating where the mud fluid was placed and the method or methods used in introducing it into the hole. If cement or other plugs were used, state the character of same and depth placed, from _____ feet to _____ feet for each plug set.

Sanded back to 3300' and dumped 4 sacks of cement.

Squeezed well with 2 sacks of hulls, 15 sacks of gel and 100 sacks of cement.

RECEIVED
STATE CORPORATION COMMISSION
MAR 6 1972
CONSERVATION DIVISION
Wichita, Kansas

Name of Plugging Contractor PIPE PULLERS, INC. (If additional description is necessary, use BACK of this sheet)
Address Box 486, Ellinwood, Kansas 67526

STATE OF KANSAS COUNTY OF BARTON, ss.
Evelyn Roth (employee of owner) or (owner or operator) of the above-described

well, being first duly sworn on oath, says: That I have knowledge of the facts, statements, and matters herein contained and the log of the above-described well as filed and that the same are true and correct. So help me God.

(Signature) Evelyn Roth
Ellinwood, Kansas (Address)

SUBSCRIBED AND SWORN TO before me this 3 day of March, 19 72

My commission expires July 7, 1972

Notary Public.

