

STATE OF KANSAS
STATE CORPORATION COMMISSION

WELL PLUGGING RECORD

Give All Information Completely
Make Required Affidavit
Mail or Deliver Report to:
Conservation Division
State Corporation Commission
212 No. Market
Wichita, Kansas

Stafford

County, Sec. 8 Twp. 21 Rge. 11 (E) West (W)

Location as "NE/CNW%SW%" or footage from lines C E/2 NE NE

Lease Owner F. G. Holl

Lease Name Paul Scheufler Well No. 3

Office Address 6427 East Kellogg, Wichita, Kansas

Character of Well (completed as Oil, Gas or Dry Hole) Dry Hole

Date well completed Dec. 22 19 68

Application for plugging filed " 19 68

Application for plugging approved " 19 68


Plugging commenced Dec. 22 19 "

Plugging completed Dec. 22 19 "

Reason for abandonment of well or producing formation

If a producing well is abandoned, date of last production 19

Was permission obtained from the Conservation Division or its agents before plugging was commenced? yes

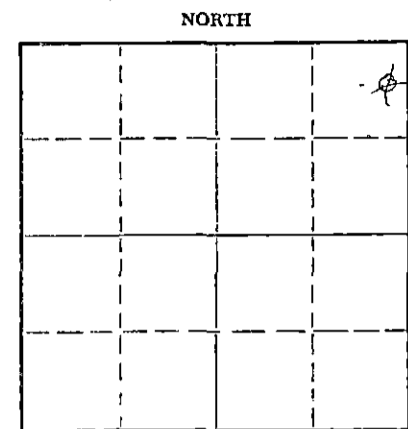

Locate well correctly on above Section Plat

Name of Conservation Agent who supervised plugging of this well Ralph Warren

Producing formation Depth to top Bottom Total Depth of Well 3484 Feet

Show depth and thickness of all water, oil and gas formations.

OIL, GAS OR WATER RECORDS

CASING RECORD

FORMATION	CONTENT	FROM	TO	SIZE	PUT IN	PULLED OUT

Describe in detail the manner in which the well was plugged, indicating where the mud fluid was placed and the method or methods used in introducing it into the hole. If cement or other plugs were used, state the character of same and depth placed, from feet to feet for each plug set.

Hole full with mud - set plug at 600' with 50 sacks cement thru drill pipe with pump truck
Come up hole to 250' - with 25 sacks cement thru drill pipe
Come to 40' = good bridge with 10 sacks cement -(1/4 hulls)
2 sacks in rat hole

RECEIVED
STATE CORPORATION COMMISSION
DEC 26 1968
CONSERVATION DIVISION
Wichita, Kansas

(If additional description is necessary, use BACK of this sheet)

Name of Plugging Contractor

Address

STATE OF Kansas, COUNTY OF Barton, ss.

Larry Curtis (employee of owner) or (owner or operator) of the above-described

well, being first duly sworn on oath, says: That I have knowledge of the facts, statements, and matters herein contained and the log of the above-described well as filed and that the same are true and correct. So help me God.

(Signature) Larry Curtis

Box 823 - Great Bend, Kansas

(Address)

SUBSCRIBED AND SWORN TO before me this 22nd day of December, 19 68

My commission expires 4-11-70

Notary Public

DRILLERS' WELL LOG

DATE COMMENCED: December 15, 1968
 DATE COMPLETED: December 22, 1968

F. G. Holl
 PAUL SCHEUFLER #3
 C E/2 NE/4 NE/4
 Sec. 8-21-11w
 Stafford County, Ks.

0 - 196' Sand & Clay
 196 - 536' Red Bed
 536 - 559' Anhydrite
 559 - 1370' Shale & Shells
 1370 - 1665' Shale & Lime
 1665 - 2045' Lime & Shale
 2045 - 2565' Shale
 2565 - 2987' Lime & Shale
 2987 - 2991' Shale
 2991 - 3007' Lime & Shale
 3007 - 3020' Lime
 3020 - 3113' Shale
 3113 - 3118' Brown Lime
 3118 - 3135' Shale
 3135 - 3365' Lime
 3365 - 3338' Shale
 3338 - 3429' conglomerate
 3429 - 3440' Simpson Sand
 3440 - 3461' Shale
 3461 - 3484 Dolomite
 3484 RTD

ELEVATION 1785 K.B.

FORMATION DATA

Anhydrite	536
Heebner	2987
Toronto	3007
Douglas	3020
Brown Lime	3113
Kansas City	3135
Base K.C.	3365
Conglomerate	3380
Simpson Sand	3429
Arbuckle	3461
RTD	3484

SURFACE PIPE: Set new 8-5/8"
 at 250' with 225 sacks of
 cement.

A F F I D A V I T

STATE OF KANSAS
 COUNTY OF BARTON

Larry Curtis of lawful age does swear and state that the facts and statements herein contained are true and correct to the best of his knowledge.

Larry Curtis

Subscribed and sworn to before me this 23 day of December 1968.

Marathy M. Hague
 Notary Public

My Comm. Expires: April 11, 1970

RECEIVED
 STATE CORPORATION COMMISSION
 DEC 26 1968
 CONSERVATION DIVISION
 Wichita, Kansas