


WELL PLUGGING RECORD

Give All Information Completely
Make Required Affidavit
Mail or Deliver Report to:
Conservation Division
State Corporation Commission
800 Bittig Building
Wichita, Kansas

NORTH

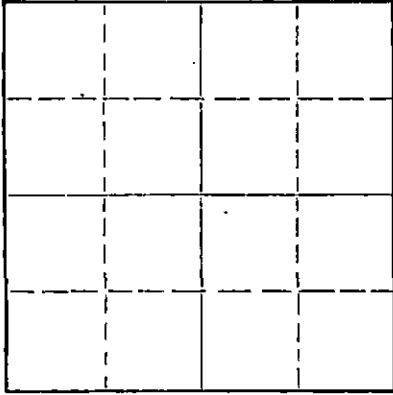

Locate well correctly on above
Section Plat

Stafford County, Sec. 6 Twp. 21 Rge. 11 KK (W)

Location as "NE/CNW/SW" or footage from lines C of S/2 NE/4
Lease Owner Veeder Supply & Development Co.
Lease Name Beck Well No. 1
Office Address Box 201, Cherryvale, Kansas
Character of Well (completed as Oil, Gas or Dry Hole) Dry Hole
Date well completed Sept. 11 1955
Application for plugging filed Sept. 12 1955
Application for plugging approved Sept. 12 1955
Plugging commenced Sept. 12 1955
Plugging completed Sept. 12 1955
Reason for abandonment of well or producing formation Dry Hole

If a producing well is abandoned, date of last production _____ 19____
Was permission obtained from the Conservation Division or its agents before plugging was commenced? Yes

Name of Conservation Agent who supervised plugging of this well Warren Horner, Great Bend, Kansas
Producing formation _____ Depth to top _____ Bottom _____ Total Depth of Well 3500 Feet
Show depth and thickness of all water, oil and gas formations.

OIL, GAS OR WATER RECORDS

CASING RECORD

FORMATION	CONTENT	FROM	TO	SIZE	PUT IN	PULLED OUT
				8 5/8"	250'	cemented w/150 sacks cement

Describe in detail the manner in which the well was plugged, indicating where the mud fluid was placed and the method or methods used in introducing it into the hole. If cement or other plugs were used, state the character of same and depth placed, from _____ feet to _____ feet for each plug set.

Plugged hole with heavy mud to 240', 1/3 sack hulls, plug and 20 sacks cement; heavy mud to 35', 1/3 sack hulls and 10 sacks cement to surface.

RECEIVED
STATE CORPORATION COMMISSION
SEP 16 1955
CONSERVATION DIVISION
Wichita, Kansas

9-16-1955

(If additional description is necessary, use BACK of this sheet)
Name of Plugging Contractor Veeder Supply and Development Company
Address Box 201, Cherryvale, Kansas

STATE OF Kansas, COUNTY OF Montgomery, ss.
Leo C. Veeder (owner or operator) of the above-described well, being first duly sworn on oath, says: That I have knowledge of the facts, statements, and matters herein contained and the log of the above-described well as filed and that the same are true and correct. So help me God.
(Signature) Leo C. Veeder
Cherryvale, Kansas (Address)

SUBSCRIBED AND SWORN TO before me this 14th day of September, 1955

My commission expires July 11, 1956
Oles Lawson Notary Public.

PLUGGING
FILE SEC 6 T 21 R 11W
BOOK PAGE 149 LINE 32

15.185.12248.0000

Veeder Supply & Dev'l. Co.



Cherryvale, Kansas

Producers Pipe & Supply Company
 Drilled for Veeder Supply & Dev'l. Co. Farm Beck No. 1 Depth 3500'
 Contractor Veeder Supply & Development Co. Pipe 250' 8 5/8" csg. cemented w/150 sacks cement
 Location C of S/2 NE/4 Sec 6 Twp. 21 Range 11W
 Commenced 8-31-1955 Completed 9-11-1955 County Stafford State Kansas

Sand and gravel	0	100	100	<u>TOPS:</u>	
Sand, shale	100	220	120		
Shale, shells	220	280	60	Heebner	3103
Shale, red bed	280	570	290	Toronto	3136
Anhydrite	570	600	30	Lansing	3153
Shale and shells	600	1145	845	Conglomerate	3404
Lime, shale streaks	1145	1500	55	Arbuckle	3468
Lime	1500	1630	130		
Lime and shale	1630	2725	1095		
Lime	2725	2790	65		
Lime and shale	2790	2820	30		
Lime	2820	2952	132		
Lime and shale	2952	3155	203		
Lime	3155	3500	345		
T. D.	3500				

AFFIDAVIT

STATE OF KANSAS)
Montgomery County) SS

Leo C. Veeder, of lawful age, being first duly sworn on oath, deposes and says:

THAT he is a resident of Cherryvale, Montgomery County, Kansas; that he knows and on oath hereby states that the above drilling log covering the Beck #1 well located in Section 6-21-11W. Stafford County, Kansas, ^{is true and correct} and further affiant saith not.

THE VEEDER SUPPLY AND DEVELOPMENT CO.

BY Leo C. Veeder
Leo C. Veeder

Subscribed and sworn to before me this 14th day of September, 1955.

Leo Lawson
Notary Public

PLUGGING
FILE SEC 6 T 21 R 11W
BOOK PAGE 149 LINE 32

RECEIVED
STATE CORPORATION COMMISSION
SEP 16 1955
CONSERVATION DIVISION
Wichita, Kansas