


STATE OF KANSAS  
STATE CORPORATION COMMISSION

Form CP-4

Give All Information Completely  
Make Required Affidavit  
Mail or Deliver Report to:  
Conservation Division  
State Corporation Commission  
212 No. Market  
Wichita, Kansas

WELL PLUGGING RECORD

NORTH

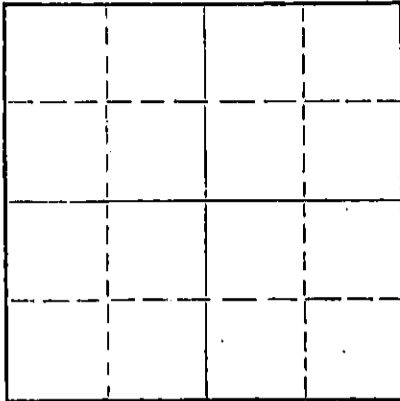

Locate well correctly on above  
Section Plat

Stafford County. Sec. 6 Twp. 21S Rge. 11 (E/W) (W)  
Location as "NE/CNWxSWx" or footage from lines. App. SE SE NE  
Lease Owner Goering-Hedrick  
Lease Name Beck (Twin) Well No. 1  
Office Address P. O. Box 296, Newton, Kansas  
Character of Well (completed as Oil, Gas or Dry Hole) Dry Hole  
Date well completed May 7, 1961  
Application for plugging filed May 7, 1961  
Application for plugging approved May 7, 1961  
Plugging commenced May 7, 1961  
Plugging completed May 7, 1961  
Reason for abandonment of well or producing formation Dry Hole

If a producing well is abandoned, date of last production 19  
Was permission obtained from the Conservation Division or its agents before plugging was commenced? Yes

Name of Conservation Agent who supervised plugging of this well Frank Broadfoot  
Producing formation \_\_\_\_\_ Depth to top \_\_\_\_\_ Bottom \_\_\_\_\_ Total Depth of Well 3460 Feet  
Show depth and thickness of all water, oil and gas formations.

OIL, GAS OR WATER RECORDS

CASING RECORD

FORMATION	CONTENT	FROM	TO	SIZE	PUT IN	PULLED OUT
				8 5/8"	285	

Describe in detail the manner in which the well was plugged, indicating where the mud fluid was placed and the method or methods used in introducing it into the hole. If cement or other plugs were used, state the character of same and depth placed, from \_\_\_\_\_ feet to \_\_\_\_\_ feet for each plug set.

Filled hole with mud to 240 feet. Set plug with hulls. Mixed 20 sacks cement through drill pipe. Filled with mud to 35 feet. Set plug with hulls and 10 sacks of cement cap to base of cellar.

DEC 26 1966  
CONSERVATION DIVISION  
WICHITA, KANSAS  
12-28-1966

(If additional description is necessary, use BACK of this sheet)  
Name of Plugging Contractor Duke Drilling Company  
Address Box 823, Great Bend, Kansas

STATE OF KANSAS, COUNTY OF HARVEY, ss.  
Albert A. Goering, part owner of the above-described well, being first duly sworn on oath, says: That I have knowledge of the facts, statements, and matters herein contained and the log of the above-described well as filed and that the same are true and correct. So help me God.

(Signature) Albert A. Goering  
(Address) \_\_\_\_\_

SUBSCRIBED AND SWORN TO before me this 27th day of December, 1966.

Evelyn Dirks  
Notary Public.

My commission expires November 29, 1969

15.185-19527.0000


WELL LOG BUREAU—KANSAS GEOLOGICAL SOCIETY  
508 East Murdock, Wichita, Kansas

Company- GOERING & HEDRICK  
Farm- Beck (Twin) No. 1

SEC. 6 T. 21 R. 11W  
APP. SE SE NE

Total Depth. 3460'  
Comm. 4-29-61 Comp. 5-7-61  
Shot or Treated.  
Contractor. Duke Drlg. Co.  
Issued. 7-6-63

County Stafford  
KANSAS

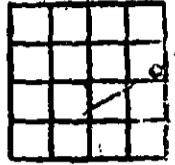

CASING:  
8" 285'

Elevation. 1814' BB

Production. Dry

Figures Indicate Bottom of Formations.

sand	40
clay & sand	220
redbed	553
Anhydrite	589
redbed	780
shale & shells	1140
salt & shale	1400
lime & shale	1640
lime-shale	1870
lime & shale	2330
lime-shale	2640
lime & shale	2781
lime	3430
Arbuckle	3460
Total Depth	

TOPS: SCOUT	
Anhydrite	553
Heebner	3004
Brown Lime	3127
Lansing	3140
Base Kansas City	3384
Conglomerate	3388
Arbuckle	3426

RECEIVED  
STATE CORPORATION COMMISSION

JUL 16 1964

CONSERVATION DIVISION  
Wichita, Kansas

*Jim Daniels Geo.*