


STATE OF KANSAS
STATE CORPORATION COMMISSION

WELL PLUGGING RECORD

Give All Information Completely
Make Required Affidavit
Mail or Deliver Report to
Conservation Division
State Corporation Comm.
245 North Water
Wichita, KS 67202

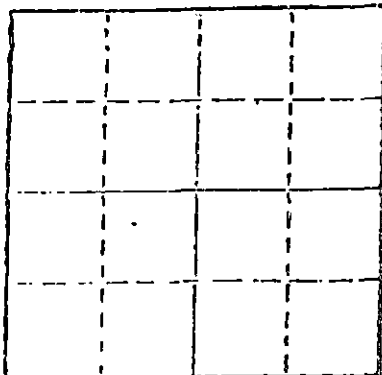

Locate well correctly on above
Section Plot

Stafford County, Sec. 6 Twp. 21S Rge. 11 E/W
Location as "NE/CNW 1/4 SW 1/4" or footage from lines
C E/2 E/2 NW
Lease Owner Thomason Oil Company
Lease Name Ringering 'A' Well No. 1
Office Address 2700 Oak St., Suite A, Hays, KS 67601
Character of Well (Completed as Oil, Gas or Dry Hole) Dry Hole
Date Well completed 7-19 1981
Application for plugging filed 7-19 1981
Application for plugging approved 7-19 1981
Plugging commenced 7-19 1981
Plugging completed 7-20 1981
Reason for abandonment of well or producing formation Dry Hole

If a producing well is abandoned, date of last production 19
Was permission obtained from the Conservation Division or
its agents before plugging was commenced? yes

Name of Conservation Agent who supervised plugging of this well William T. Owen
Producing formation _____ Depth to top _____ Bottom _____ Total Depth of Well _____
Show depth and thickness of all water, oil and gas formations.

OIL, GAS OR WATER RECORDS

CASING RECORD

FORMATION	CONTENT	FROM	TO	SIZE	PUT IN	PULLED OUT
				8-5/8"	308'	-0-

Describe in detail the manner in which the well was plugged, indicating where the mud fluid was placed and the method or methods used in introducing it into the hole. If cement or other plugs were used, state the character of same and depth placed, from _____ feet to _____ feet for each plug set.

Mud laden fluid 3472' - 520'
50 sks cement @ 520'
40 sks cement @ 300'
10 sks cement @ 40'
10 sks cement in rat hole.

(If additional description is necessary, use BACK of this sheet)

Name of Plugging Contractor Emphasis Oil Operations

STATE OF KANSAS COUNTY OF RUSSELL, ss.
Joe K. Branum (employee of owner) or (owner or operator)
of the above-described well, being first duly sworn on oath, says: That I have knowledge of the facts, statements, and matters herein contained and the log of the above-described well as filed and that the same are true and correct. So help me God.

(Signature) Joe K. Branum

P. O. Box 506, Russell, Kansas 67665
(Address)

SUBSCRIBED AND SWORN TO before me this 21st day of July, 19 81.

My commission expires February 6, 1984.

Glenda R. Tiffin
Glenda R. Tiffin Notary Public.



GLENDA R. TIFFIN
Russell County, Ks.
My Appl. Exp. 2-6-84

RECEIVED
STATE CORPORATION COMMISSION

JUL 22 1981

CONSERVATION DIVISION
Wichita, Kansas

EMPHASIS OIL OPERATIONS

P. O. Box 506
Russell, Kansas 67665

DRILLERS LOG

OPERATOR: Thomason Oil Company
2700 Oak St., Suite A
Hays, Kansas 67601

CONTRACTOR: Emphasis Oil Operations
P. O. Box 506
Russell, Kansas 67665

LEASE: Ringering 'A' WELL: #1

LOCATION: C E/2 E/2 NW
Section 6-21S-11W
Stafford County, Kansas

Total Depth: 3472'

Elevation: 1820' Gr.

Commenced: 7-12-81

Completed: 7-20-81

Casing: 8-5/8" @ 308' with 250 sks cement

Status: Dry Hole

DEPTHS & FORMATIONS

(All measurements from K.B.)

Topsoil & Sand	30'	Shale	2257'
Sand & Shale	1145'	Lime & Shale (R.T.D.)	3472'

STATE OF KANSAS)
) ss:
COUNTY OF RUSSELL)

I, Joe K. Branum, of Emphasis Oil Operations, state that the above and foregoing is a true and correct log of the above captioned well.




RECEIVED
STATE CORPORATION COMMISSION

JUL 22 1981

Joe K. Branum
Joe K. Branum
CONSERVATION DIVISION
Wichita, Kansas

Subscribed and sworn to before me this 21st day of July, 1981.

My Commission Expires: February 6, 1984.

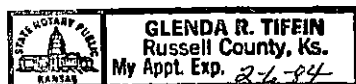

Glenda R. Tiffin
Notary Public