


Give All Information Completely
Make Required Affidavit
Mail or Deliver Report to:
Conservation Division
State Corporation Commission
800 Bitting Building
Wichita, Kansas

WELL PLUGGING RECORD

NORTH

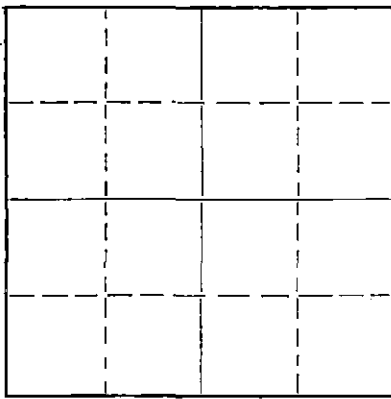

Locate well correctly on above Section Flat

Stafford County, Sec. 6 Twp. 21 Rge. 11 (E) (W)
Location as "NE/CNW $\frac{1}{4}$ SW $\frac{1}{4}$ " or footage from lines E $\frac{1}{2}$ W $\frac{1}{2}$ NW $\frac{1}{4}$
Lease Owner Phillips & Hanson
Lease Name Ringering Well No. 1
Office Address 1407 Union National Bank Bldg., Wichita, Kansas
Character of Well (completed as Oil, Gas or Dry Hole) dry hole
Date well completed July 20 1950
Application for plugging filed July 27 1950
Application for plugging approved July 27 1950
Plugging commenced July 29 1950
Plugging completed August 3 1950
Reason for abandonment of well or producing formation

If a producing well is abandoned, date of last production 19
Was permission obtained from the Conservation Division or its agents before plugging was commenced? Yes

Name of Conservation Agent who supervised plugging of this well C. D. Stough
Producing formation Depth to top Bottom Total Depth of Well 3518 Feet
Show depth and thickness of all water, oil and gas formations.

OIL, GAS OR WATER RECORDS

CASING RECORD

Formation	Content	From	To	Size	Put In	Pulled Out
				8 5/8"	272'	none
				5 1/2"	3460'	2811'

Describe in detail the manner in which the well was plugged, indicating where the mud fluid was placed and the method or methods used in introducing it into the hole. If cement or other plugs were used, state the character of same and depth placed, from.....feet to.....feet for each plug set.

Lane-Wells plug set at 3330'. Crushed rock from 3330' to 3284', set 4 sacks cement from 3284' to 3259'. Filled with heavy mud from 3259' to 280'. Set permanent rock bridge from 280' to 270' with 15 sacks cement from 270' to 225'. Heavy mud from 225' to 40' and permanent rock bridge from 40' to 30'. 10 sacks cement from 30' to bottom of cellar.

Aug 17 1950 8-17-1950

State of Kansas

(If additional description is necessary, use BACK of this sheet)


Correspondence regarding this well should be addressed to Phillips & Hanson
Address 1407 Union National Bank Bldg., Wichita, Kansas

STATE OF KANSAS, COUNTY OF SEDGWICK, ss.
Nelle A. Salmon (employee of owner) or (owner/operator) of the above-described well,
being first duly sworn on oath, says: That I have knowledge of the facts, statements, and matters herein contained and the log of the above-described well as filed and that the same are true and correct. So help me God.
(Signature) Nelle A. Salmon
1407 Union National Bank Bldg., Wichita, Kansas (Address)

SUBSCRIBED AND SWORN to before me this 15th day of August 19 50

My commission expires April 14, 1952

Eleanor Doty Notary Public.

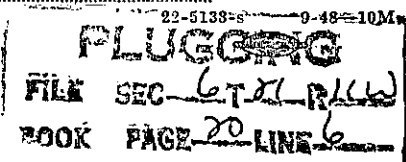

15.185.12247.0000

Company: Phillips & Hanson
Farm: Ringering #1
Comm: June 30, 1950
Comp: July 20, 1950
Contractor: Penguin Petroleum, Inc.

Section 6, T 21 S, R 11 W
E/2 W/2 NW/4
Stafford County, Kansas
Rotary Tools
Elevation: 1825' D.F.
Total Depth: 3518'
D & A

Casing: 8 5/8" @ 272'
5 1/2" @ 3458' corr.

0-210 Sand & gravel
-272 Red bed
-607 Red rock
-619 Lime, anhydrite
-715 Red rock
-1465 Shale & shells
-1610 Shale & lime
-1830 Lime broken
-1975 Lime & shale
-2050 Shale
-2180 Lime broken
-2645 Shale & shells
-2707 Shale
-2743 Sandy shale
-3105 Lime
-3160 Shale
-3410 Lime
-3420 Shale
-3465 Shale

R.T.D. 3465' = 3463' Drill pipe correction to top of hole
R.U.S.T.

-3518 Dolomite

Total Depth 3518'

Tops: (corrected)

Topeka @ 2740'
Heebner @ 3016'
"Brown Lime" @ 3134'
Lansing-Kansas City @ 3156'
Simpson shale @ 3421'
Arbuckle @ 3457'

Completion Data: 3465' = 3463' Drill pipe correction to top of hole
Rotary Total Depth 3463' corr.
5 1/2" @ 3458' corr.
Drill plug
Show of oil and gas
Drilled deeper to 3518'
Water @ 3500'
Ran Radioactive log
Set Lane Wells plug @ 3330'
Perf. 47 shots 3292-3300'
Swab 2 BWPH
D & A

FILED
AUG 1 1950
STAFFORD COUNTY
KANSAS

Certified to be a true copy of the well log as indicated on daily reports.
PENGUIN PETROLEUM, INC.

By Jack Brown

Subscribed and sworn to before me, the undersigned, a Notary Public, in and for Sedgwick County, Kansas, this 1st day of August, 1950.

My Commission Expires:

October 13, 1952

S.D. Strickland
Notary Public

PLUGGING
FILE SEC 67-21-11W
BOOK PAGE 20 LINE 6