


WELL PLUGGING RECORD

Give All Information Completely  
Make Required Affidavit  
Mail or Deliver Report to:  
Conservation Division  
State Corporation Commission  
800 Biting Building  
Wichita, Kansas

NORTH

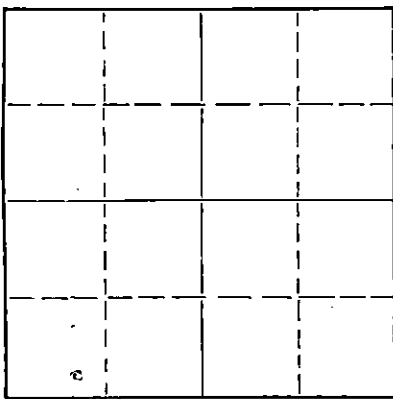

Locate well correctly on above  
Section Plat

Stafford County. Sec. 6 Twp. 21 Rge. 11 (E) (W)  
Location as "NE/CNW/SW" or footage from lines SE SW SW  
Lease Owner Duke Drilling Company  
Lease Name SPARKS Well No. 3  
Office Address Box 823 - Great Bend, Kansas  
Character of Well (completed as Oil, Gas or Dry Hole) Dry Hole  
Date well completed Dec. 31 19 66  
Application for plugging filed "30" 19 66  
Application for plugging approved """ 19 66  
Plugging commenced Dec. 31 19 66  
Plugging completed """ 19 66  
Reason for abandonment of well or producing formation \_\_\_\_\_

If a producing well is abandoned, date of last production \_\_\_\_\_ 19 \_\_\_\_\_  
Was permission obtained from the Conservation Division or its agents before plugging was commenced? yes

Name of Conservation Agent who supervised plugging of this well Archie Elving  
Producing formation \_\_\_\_\_ Depth to top \_\_\_\_\_ Bottom \_\_\_\_\_ Total Depth of Well 3465 Feet  
Show depth and thickness of all water, oil and gas formations.

OIL, GAS OR WATER RECORDS

CASING RECORD

FORMATION	CONTENT	FROM	TO	SIZE	PUT IN	PULLED OUT

Describe in detail the manner in which the well was plugged, indicating where the mud fluid was placed and the method or methods used in introducing it into the hole. If cement or other plugs were used, state the character of same and depth placed, from \_\_\_\_\_ feet to \_\_\_\_\_ feet for each plug set.

Filled hole w/heavy mud to 240 1/3 sack hulls  
Set Plug 25 sacks cement thru drill pipe.  
Filled hole with heavy mud to 40'  
Made bridge set plug and 10 sacks cement -  
2 sacks in rat hole

RECEIVED  
STATE CORPORATION COMMISSION  
JAN 2 1967  
CONSERVATION DIVISION  
Wichita, Kansas

(If additional description is necessary, use BACK of this sheet)

Name of Plugging Contractor \_\_\_\_\_  
Address \_\_\_\_\_

STATE OF KANSAS, COUNTY OF BARTON, ss.  
L. O. CHUBB (employee of owner) or (owner/proprietor) of the above-described well, being first duly sworn on oath, says: That I have knowledge of the facts, statements, and matters herein contained and the log of the above-described well as filed and that the same are true and correct. So help me God.

(Signature) L O Chubb

Box 823 - Great Bend, Ks.  
(Address)

SUBSCRIBED AND SWORN TO before me this 31st day of December, 19 66.

My commission expires 4-11-70

Dorothy M. Hague  
Dorothy M. Hague Notary Public.



W E L L L O G

DATE COMMENCED: December 21, 1966  
DATE COMPLETED: December 31, 1966

Duke Drilling Company  
SPARKS #3  
SE SW SW  
Section 6-21s-11w  
Stafford County, Kansas

0	-	75'	Sand
75	-	230'	Sand & Shale
230	-	582'	Red Bed
582	-	610'	Anhydrite
610	-	1615'	Shale - Shells
1615	-	2050'	Lime & Shale
2050	-	2680'	Shale & Lime
2680	-	3020'	Lime
3020	-	3024'	Shale
3024	-	3039'	Lime & Shale
3039	-	3053'	Lime
3053	-	3144'	Shale
3144	-	3161'	Lime Shale
3161	-	3410'	Lime
3410	-	3465'	Conglomerate

ELEVATION: 1815 K.B.

FORMATION DATA

ANHYDRITE	582
HEEBNER	3020
BROWN LIME	3144
LANSING	3161
CONGLOMERATE	3410
R.T.D.	3465

SURFACE CASING: Set 8-5/8"  
at 257' w/225 sacks cement.

A F F I D A V I T

STATE OF KANSAS  
COUNTY OF BARTON ) ss.

L. O. Chubb, of lawful age, does swear that the facts and statements herein contained are true and correct to the best of his knowledge.

*L. O. Chubb*

Subscribed and sworn to before me this 31 day of December, 1966

My Comm. Expires:

April 11, 1970

*Dorothy M. Hague*  
Dorothy M. Hague NOTARY PUBLIC

RECEIVED  
STATE CORPORATION COMMISSION

JAN 3 1967

CONSERVATION DIVISION  
Wichita, Kansas