

15-009-06777-00-00

STATE OF KANSAS
STATE CORPORATION COMMISSION

Give All Information Completely
Make Required Affidavit
Mail or Deliver Report to:
Conservation Division
State Corporation Commission
212 No. Market
Wichita, Kansas

WELL PLUGGING RECORD

Barton County. Sec. 5 Twp. 16 Rge. 13 (E) (W)

Location as "NE/CNW/SW" or footage from lines. CN/2NW/SW

Lease Owner Shell Oil Company

Lease Name J. C. Bitter Well No. 2 SWD

Office Address 1700 Broadway Denver, Colorado 80202

Character of Well (completed as Oil, Gas or Dry Hole) SWD well

Date well completed DEC. 5 1955

Application for plugging filed MARCH 28 1969

Application for plugging approved April 1 1969


Plugging commenced June 12 1969

Plugging completed June 12 1969

Reason for abandonment of well or producing formation No longer needed for disposal.

If a producing well is abandoned, date of last production 19

Was permission obtained from the Conservation Division or its agents before plugging was commenced? Yes.

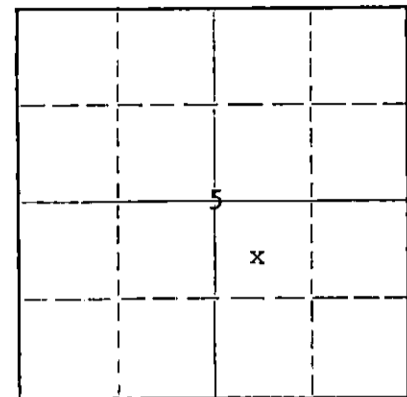

Locate well correctly on above Section Plat

Name of Conservation Agent who supervised plugging of this well Donald Truen

Producing formation _____ Depth to top _____ Bottom _____ Total Depth of Well 3620 Feet

Show depth and thickness of all water, oil and gas formations.

OIL, GAS OR WATER RECORDS

CASING RECORD

FORMATION	CONTENT	FROM	TO	SIZE	PUT IN	PULLED OUT
Surface				10 3/4"	637'	None
S.W.D.				7"	3457'	None
Disposal Form		3457	3620	-	None	----

Describe in detail the manner in which the well was plugged, indicating where the mud fluid was placed and the method or methods used in introducing it into the hole. If cement or other plugs were used, state the character of same and depth placed, from 0 feet to 3620 feet for each plug set.

Moved in R. U. mixed 30 sxs Hawco Gel and 6 sxs hulls, followed by 275 sxs light weight cement. Pump pres. 500. Standing pres. 150. Hooked on Annulus. Pumped 75 sxs light weight cement. Pump pres. 600. Standing press 500. Welded on steel plate.

RECEIVED
STATE CORPORATION COMMISSION
JUN 18 1969
CONSERVATION DIVISION
Wichita, Kansas

(If additional description is necessary, use BACK of this sheet)
Name of Plugging Contractor Shell Oil Company By E. L. Bearden
Address 1700 Broadway Denver, Colorado 80202

STATE OF Colorado, COUNTY OF Denver, ss.
C. A. Wischoff (employee of owner) or (owner or operator) of the above-described well, being first duly sworn on oath, says: That I have knowledge of the facts, statements, and matters herein contained and the log of the above-described well as filed and that the same are true and correct. So help me God.

(Signature) W. M. Koch

Oklahoma Production Department
1700 Broadway, Denver, Colorado 80202

SUBSCRIBED AND SWORN TO before me this 17th day of June, 1969

[Signature] Notary Public.

My commission expires July 1, 1969