

15-009-16106-00-00

9


STATE OF KANSAS
STATE CORPORATION COMMISSION

Form CP-4

Give All Information Completely
Make Required Affidavit
Mail or Deliver Report to:
Conservation Division
State Corporation Commission
211 No. Broadway
Wichita, Kansas

WELL PLUGGING RECORD

Barton County, Sec. 5 Twp. 16 Rge. 13 (W)
Location as "NE/CNW/SE/SW" or footage from lines CNH Nip Ne
Lease Owner Wichita Iron & Metal
Lease Name Bitter Well No. 1
Office Address _____
Character of Well (completed as Oil, Gas or Dry Hole) Oil
Date well completed 3-24-1940
Application for plugging filed 4/30/68 19
Application for plugging approved 4/30/68 19
Plugging commenced 6-18 1968
Plugging completed 6-20 1968
Reason for abandonment of well or producing formation SWD.

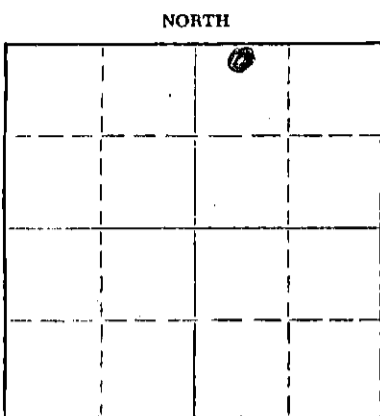

Locate well correctly on above
Section Plat

If a producing well is abandoned, date of last production _____ 19____
Was permission obtained from the Conservation Division or its agents before plugging was commenced? Yes

Name of Conservation Agent who supervised plugging of this well Donald Truman
Producing formation _____ Depth to top _____ Bottom _____ Total Depth of Well 3353 Feet
Show depth and thickness of all water, oil and gas formations.

OIL, GAS OR WATER RECORDS

CASING RECORD

FORMATION	CONTENT	FROM	TO	SIZE	PUT IN	PULLED OUT
	RECEIVED			8"	883'	0
	STATE CORPORATION COMMISSION			52	3348	873'
	JUN 27 1968					
	CONSERVATION DIVISION					
	Wichita, Kansas					


Describe in detail the manner in which the well was plugged, indicating where the mud fluid was placed and the method or methods used in introducing it into the hole. If cement or other plugs were used, state the character of same and depth placed, from _____ feet to _____ feet for each plug set.

Bridge at 870' run 5 sacks of cement 870 to 840'
Set plug at 370' rock to 350', run 5 yards of ready
mix cement from 350' to base of cellar

(If additional description is necessary, use BACK of this sheet)
Name of Plugging Contractor Wichita Iron & Metal Pipe Pulling Co.
Address Box 156 Ellinwood, Kansas

STATE OF KANSAS, COUNTY OF SEDGWICK, ss.
Ray Stekoll (employee of owner) or (owner or operator) of the above-described well, being first duly sworn on oath, says: That I have knowledge of the facts, statements, and matters herein contained and the log of the above-described well as filed and that the same are true and correct. So help me God.

(Signature) Wichita Iron & Metal Corp
Ray Stekoll
(Address) _____

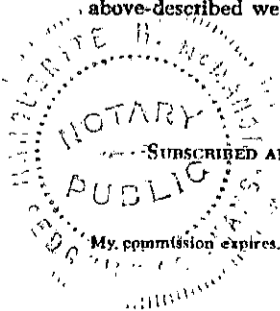

SUBSCRIBED AND SWORN to before me this 27th day of June, 1968.

Marguerite H. McMahon
Marguerite H. McMahon
Notary Public.

WELL LOG
412 Union National Bank Bldg, Wichita, Kansas.


DARBY PETROLEUM CORPORATION.
Bitter No. 1.

SEC. 5 T. 16 R. 13W.
CNL NW NE

15-009-16106-00-00

Total Depth. 3353
Comm. 3-8-40 Comp. 3-24-40
Shot or Treated.
Contractor.
Issued, 5-4-40

County Barton

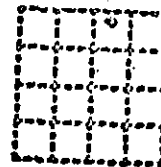

CASING.

8" 883'
5" 3348'

Elevation.

Production. Pot. 51 B.

Figures Indicate Bottom of Formations.

shale and shells	320
iron	360
shale and shells	560
shale	695
shale and gyp shells	725
shale and shells	881
anhydrite	908
shale	950
anhydrite and gyp	1010
shale red	1035
shale and shells	1275
shale	1340
salt	1425
shale and shells	1625
lime and shale	1635
shale	1670
lime	1690
shale	1800
lime	1940
shale and shells	2015
lime	2055
shale	2095
lime	2135
shale	2200
lime	2215
shale and lime shells	2260
shale	2565
shale and lime shells	2580
lime	2670
shale	2710
shale lime shells	2780
lime and shale	2800
lime	3205
chert and lime	3240
broken lime and lime shells	3300
lime	3330
lime and green shale	3338
lime	3353

Total Depth. 2787 -
Top Arbuckle 3082 -
Top Arbuckle 3345 -

Drilled Cement @ 3348

Drilled Deeper 3353 T.D.

Filled 375' oil - 1 hr.

Filled 600' oil - 2 hrs.

Filled 850' Oil - 3 hrs.

Filled 1550' oil - 7 hrs.

2000 gal acid.

pumped 8 bbls oil per hr.

shot 10 qts & 1000 Gala. Acid, Pumped 63 B. 1st 3 hrs, then 17.38, 15.75, 15.75 and 15.75 B.P.Hr.

Total 127.63 bbls in 7 hrs.

pumped 16 bbls in 1 hr.

Completed for 51 bbls.

8544
42/3353
332

1.3
258/3324
258/3324

36
13.5
25-30/3324

24
42