


WELL PLUGGING RECORD

Give All Information Completely
Make Required Affidavit
Mail or Deliver Report to:
Conservation Division
State Corporation Commission
211 No. Broadway
Wichita, Kansas

McPherson County, Sec. 32 Twp. 21 Rge. 2 ~~xxx~~ (W)

Location as "NE/CNW/SW" or footage from lines NE NE SE
Lease Owner E. K. Carey Drilling Co., Inc.
Lease Name Goering Well No. 1
Office Address Box 620, McPherson, Kansas
Character of Well (completed as Oil, Gas or Dry Hole) Dry hole
Date well completed August 6, 19 58
Application for plugging filed August 5, 19 58
Application for plugging approved August 5, 19 58
Plugging commenced 8 A.M. August 6, 19 58
Plugging completed 8:30 A.M. August 6, 19 58
Reason for abandonment of well or producing formation Dry hole

NORTH

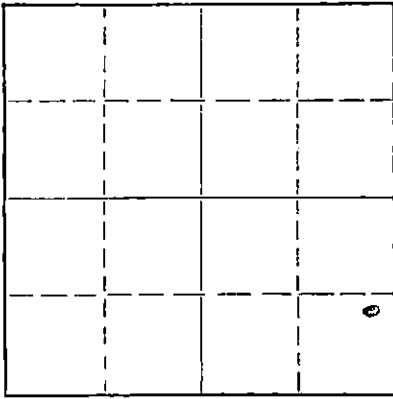

Locate well correctly on above
Section Plat

If a producing well is abandoned, date of last production _____ 19____
Was permission obtained from the Conservation Division or its agents before plugging was commenced? Yes

Name of Conservation Agent who supervised plugging of this well Gilbert J. Loman, Holyrood, Kansas
Producing formation _____ Depth to top _____ Bottom _____ Total Depth of Well 3669 Feet
Show depth and thickness of all water, oil and gas formations.

OIL, GAS OR WATER RECORDS

CASING RECORD

FORMATION	CONTENT	FROM	TO	SIZE	PUT IN	PULLED OUT
				8-5/8"	219	None

Describe in detail the manner in which the well was plugged, indicating where the mud fluid was placed and the method or methods used in introducing it into the hole. If cement or other plugs were used, state the character of same and depth placed, from 210-150 feet to 35-7 feet for each plug set.

Circulated heavy mud on bottom, layed down 1/2 half drill pipe, circulated heavy mud around again, layed down rest of drill pipe, ran line and filled hole to 210' with heavy mud, pushed plug to 210'. Mix 20 sacks cement and pumped thru drill pipe by Halliburton. Ran line and filled with heavy mud to 35', set plug and mixed 10 sacks cement and filled to bottom of cellar floor. Through 8:30 A.M.

(If additional description is necessary, use BACK of this sheet)

Name of Plugging Contractor Capitt Drilling, Inc. Rig
Address 1014-16 Union Center, Wichita 2, Kansas

STATE OF Kansas COUNTY OF McPherson, ss.
Arland Bruce, Superintendent (employee of owner) or (owner or operator) of the above-described well, being first duly sworn on oath, says: That I have knowledge of the facts, statements, and matters herein contained and the log of the above-described well as filed and that the same are true and correct. So help me God.

(Signature) Arland Bruce
Box 620, McPherson, Kansas
(Address)

SUBSCRIBED AND SWORN TO before me this 6th day of August, 19 58

My commission expires November 13, 1960

Notary Public.
STATE CORPORATION COMMISSION

PLUGGING
FILE SEC. 32 T. 21 R. 2W
BOOK PAGE 12L LINE 10

AUG 13 1958
CONSERVATION DIVISION
Wichita, Kansas
8-13-1958

ROTARY DRILLING LOG

OPERATOR: E. K. Carey Drilling Co., Inc.
 GOERING NO. 1
 NE NE SE Sec. 32-21-2W,
 McPherson County, Kansas

CONTRACTOR: Capitt Drilling, Inc.
 COM: 7-24-58
 Comp: 8-6-58

Remarks: Set 8-5/8" surface pipe at
 219' cemented with 125 sacks Pozmix,
 2% C.C.

Formations:

Soil	5'
Sand	120'
Shale & Lime Streaks	330'
Lime & Shale	970'
Sandy Shale	1056'
Shale w/Lime Streaks	1526'
Shale & Lime	1767'
Shale & Lime Streaks	1825'
Lime & Shale	1881'
Lime & Shale Breaks	2010'
Lime	2085'
Lime Shale Breaks	2170'
Shale & Lime Streaks	2250'
Sand & Shale	2280'
Sandy Shale & Lime	2410'
Lime	2465'
Lime & Shale	2498'
Lime	2724'
Lime w/Shale Breaks	2785'
Lime & Shale	2890'
Lime & Shale Streaks	2976'
Lime & Shale	3110'
Lime	3165'
Lime & Chert	3255'
Lime (Cherty)	3284'
Lime & Chert	3316'
Lime	3417'
Shale & Lime	3435'
Shale	3500'
Sand	3533'
Lime & Shale	3591'
Lime	3650'
Sand	3669'

Rotary Total Depth (D&A) 3669'

We certify the above log is true and correct to the best of our knowledge and belief.

CAPITT DRILLING, INC.

R-R. McNicol
 R. R. McNicol

PLUGGING
 FILE SEC. 32 T. 21 R. 2W
 BOOK PAGE 121 LINE 10

RECEIVED
 STATE CONSERVATION COMMISSION

AUG 13 1958

CONSERVATION DIVISION
 Wichita, Kansas