


STATE OF KANSAS
STATE CORPORATION COMMISSION

Give All Information Completely
Make Required Affidavit
Mail or Deliver Report to
Conservation Division
State Corporation Commission
245 North Water
Wichita, KS 67202

FORM CP-4

WELL PLUGGING RECORD

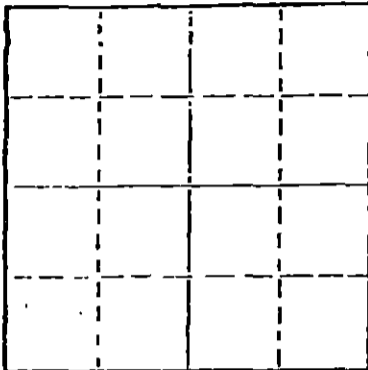

Locate well correctly on above
Section Plat

Stafford County, Sec 4 Twp 21 Rge 14W (E) (W)
Location as "NE/CNW/SE" or footage from lines S/2 S/2 SE
Lease Owner Cheyenne Exploration, Inc.
Lease Name Asher Well No. C-2
Office Address P. O. Box 11284, Wichita, KS 67202
Character of Well (completed as Oil, Gas or Dry Hole) Oil
Date well completed _____ 19____
Application for plugging filed 12-02-74 19____
Application for plugging approved 12-02-74 19____
Plugging commenced _____ 19____
Plugging completed 12-10-74 19____
Reason for abandonment of well or producing formation _____
If a producing well is abandoned, date of last production _____ 19____
Was permission obtained from the Conservation Division or its agents before plugging was commenced? Yes

Name of Conservation Agent who supervised plugging of this well G. Russell Biberstein
Producing formation _____ Depth to top _____ Bottom _____ Total Depth of Well 3500 Feet
Show depth and thickness of all water, oil and gas formations.

OIL, GAS OR WATER RECORDS

CASING RECORD

FORMATION	CONTENT	FROM	TO	SIZE	PUT IN	PULLED OUT

Describe in detail the manner in which the well was plugged, indicating where the mud fluid was placed and the method or methods used in introducing it into the hole. If cement or other plugs were used, state the character of same and depth placed, from _____ feet to _____ feet for each plug set.

402 ft 10 3/4 surface cemented with 225 sacks. 3500 ft 7' long string cemented with 225 sacks. Top perf. 3451 ft. Sand to 3000 ft, 7 sacks cement with bailer. Pulled 1900 ft 7'. Set 10 ft rock bridge at 200' ft, 35 sacks cement 10 ft rock bridge at 40 ft, 15 sacks cement to surface.

Name of Plugging Contractor Kansas Minerals Corporation
Address _____
(If additional description is necessary, use BACK of this sheet)

STATE OF _____ COUNTY OF _____, ss.

_____, (employee of owner) or (owner or operator) of the above-described well, being first duly sworn on oath, says: That I have knowledge of the facts, statements, and matters herein contained and the log of the above-described well as filed and that the same are true and correct. So help me God.

(Signature) _____

(Address) _____

Subscribed and sworn to before me this _____ day of _____, 19____

My commission expires _____

Notary Public.

Cheyenne Exploration, Inc.

Drillers Log - confirmed from Geological Report.

Beatrice Asher C-2 Well

S/2 S/2 SE Sec. 4, Township 21S, Range 14 West, Stafford County, Ks.

Total Depth 3500 ft.

Commenced Dec. 14, 1968

Completed December 31, 1968

Contractor: Gas Industries, Inc.

Elev. 1947 Kelly Bushing

1944 Derrick Flour

1942 Ground level

Casing

Surface

Oil string casing

Hole size 13" to 402'

8 5/8" from 402' to 3500 ft.

Red Bed	0 to 400
Red Bed Shells	400 to 1020
Shale and shells	1020 to 1940
Lime	1940 to 2080
Lime and shale	2080 to 5190
Lime	3190 to 3400
	3400 to 3500

Geological tops

Hebner Shale	3210 - 1263
Toronto	3222 - 1275
Brown Lime	3317 - 1370
Lansing	3328 - 1381

RECEIVED
STATE CORPORATION COMMISSION

DEC 2 1974

CONSERVATION DIVISION
Wichita, Kansas