


WELL PLUGGING RECORD

Give All Information Completely
Make Required Affidavit
Mail or Deliver Report to:
Conservation Division
State Corporation Commission
800 Bittling Building
Wichita, Kansas

Stafford County. Sec. 4 Twp. 21 Rge. 14 West (W)

Location as "NE/CNW $\frac{1}{4}$ SW $\frac{1}{4}$ " or footage from lines NE NE SE
Lease Owner Anschutz Drilling Company
Lease Name Asher Well No. 1
Office Address 1307 $\frac{1}{2}$ Main Street, Great Bend, Kansas
Character of Well (completed as Oil, Gas or Dry Hole) Dry Hole
Date well completed January 6 1951
Application for plugging filed January 15 1951
Application for plugging approved January 17 1951
Plugging commenced February 4 1951
Plugging completed February 7 1951
Reason for abandonment of well or producing formation Dry
If a producing well is abandoned, date of last production None 19
Was permission obtained from the Conservation Division or its agents before plugging was commenced? Yes

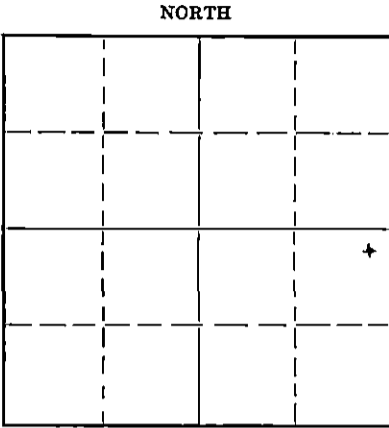

Locate well correctly on above Section Plat

Name of Conservation Agent who supervised plugging of this well Stough
Producing formation Arbuckle Depth to top 3601 Bottom 3605 Total Depth of Well 3605 Feet
Show depth and thickness of all water, oil and gas formations.


OIL, GAS OR WATER RECORDS

CASING RECORD

Formation	Content	From	To	Size	Put In	Pulled Out
Arbuckle	Water	3601	3605	5 $\frac{1}{2}$ "	3602	3065

Describe in detail the manner in which the well was plugged, indicating where the mud fluid was placed and the method or methods used in introducing it into the hole. If cement or other plugs were used, state the character of same and depth placed, from.....feet to.....feet for each plug set.

Rocked hole from 3475' to 3430' and ran 5 sacks cement
Mudded hole from 3380' to 260' set 10' rock bridge and ran 15 sacks cement
Mudded to 40', set rock bridge and ran 5 sacks cement
Well completed

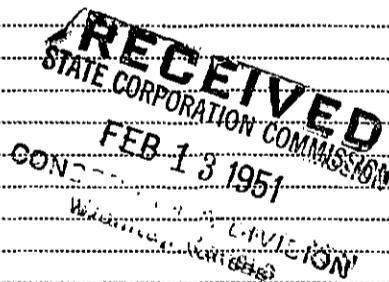

(If additional description is necessary, use BACK of this sheet)

Correspondence regarding this well should be addressed to Anschutz Drilling Company
Address 1307 $\frac{1}{2}$ Main Street
Great Bend, Kansas "Attn. Mr. Myers"

STATE OF Kansas, COUNTY OF Barton, ss.
Edw. C. Myers, Jr. (employee of owner) or (owner/operator) of the above-described well,
being first duly sworn on oath, says: That I have knowledge of the facts, statements, and matters herein contained and the log of the above-described well as filed and that the same are true and correct. So help me God.

(Signature) Edw. C. Myers Jr.
1307 $\frac{1}{2}$ Main Street, Great Bend, Kansas
(Address)

SUBSCRIBED AND SWORN to before me this 12th day of February, 1951

My commission expires July 21, 1954 Notary Public.

PLUGGING
FILE SEC 4 T 21 R 14W
BOOK PAGE 56 LINE 6

DRILLER'S LOG
 ANSCHUTZ DRILLING COMPANY
 #1 ASHER
 NE NE SE - Section 4-21S-14W
 Stafford County, Kansas

0	75	Sand
75	155	Sand
155	395	Shale & shells
395	410	Sand
410	470	Red Bed & Shale
470	530	Shale & Red Bed
530	550	Sand
550	700	Red Rock & Shale
700	817	Red rock & shells
817	824	Anhydrite
824	845	Anhydrite
845	1235	Red Bed & Shale
1235	1575	Shale, Shells & Salt
1575	1640	Shale & shells
1640	1740	Broken lime
1740	1860	Lime & shale
1860	2005	Shale & broken lime
2005	2125	Broken lime
2125	2270	Lime & shale
2270	2290	Lime & shale
2290	2370	Shale & shells
2370	2525	Shale & shells
2525	2710	Shale & shells
2710	2735	Lime
2735	2875	Shale & lime
2875	2965	Lime
2965	3030	Lime
3030	3090-	Lime
3090	3145	Lime
3145	3200	Lime
3200	3310	Sandy shale & lime
3310	3362	Lime
3362	3410	Lime
3410	3420	Lime
3420	3454	Lime
3454	3460	Lime
3460	3540	Lime
3540	3575	Lime
3575	3605	Shale & lime
3605	3608	Arbuckle Lime
3608		ROTARY TOTAL DEPTH

COMMENCED: 12/16/50
 COMPLETED: 1/7/51

TOPS:

Heeb. 3194
 B. L. 3295
 Lans. 3305
 Arb. 3604
 RTD 3608

CASING RECORD:

Set 8-5/8" surface casing @ 824' with 450 sacks cement and 4 CC.

Set 5-1/2" oil string of casing @ 3605' with 100 sacks cement.

Temporarily Abandoned.

STATE OF KANSAS)
) SS
 COUNTY OF SEDGWICK)

I hereby affirm that the above and foregoing is a true and correct copy of the log of the #1 ~~XXXXXX~~, located in the NE NE SE of Section 4-21S-14W, Stafford Asher County, Kansas.

ANSCHUTZ DRILLING COMPANY, INC.

RECEIVED
 STATE CORPORATION COMMISSION
 FILED PAGE 56
 6 JAN 16 1951
 CONSERVATION DIVISION
 Wichita, Kansas

M. W. Smith
 M. W. Smith

Subscribed and sworn to before me this 15th day of January, 1951.

Teresa Meeker
 Notary Public

My commission expires: January 21, 1954.