

STATE CORPORATION COMMISSION OF KANSAS
OIL & GAS CONSERVATION DIVISION
WELL COMPLETION OR RECOMPLETION FORM
ACO-1 WELL HISTORY
DESCRIPTION OF WELL AND LEASE

Operator: License # 09408
Name Trans Pacific Oil Corporation
Address 410 One Main Place
City/State/Zip Wichita, KS 67202

Purchaser

Operator Contact Person Alan D. Banta
Phone (316) 262-3596

Contractor: License # 05841
Name Trans Pac Drilling, Inc.

Wellsite Geologist Ernie Morrison
Phone (316) 262-3596

Designate Type of Completion

New Well Re-Entry Workover
 Oil SWD Temp Abd
 Gas Inj Delayed Comp.
 Dry Other (Core, Water Supply etc.)

If OWWO: old well info as follows:

Operator
Well Name
Comp. Date Old Total Depth

WELL HISTORY

Drilling Method:

Mud Rotary Air Rotary Cable

12/12/88 12/18/88 12/19/88
Spud Date Date Reached TD Completion Date

3742'
Total Depth PBD

Amount of Surface Pipe Set and Cemented at 370 feet
Multiple Stage Cementing Collar Used? Yes No
If yes, show depth set feet
If alternate 2 completion, cement circulated from feet depth to w/SX cmt
Cement Company Name
Invoice # A I I D r o

API NO. 15-185-22,562.0000
County Stafford
NE SW NW Sec. 10 Twp. 21 Rge. 14 East X West

3630 Ft North from Southeast Corner of Section
4290 Ft West from Southeast Corner of Section
(Note: Locate well in section plat below)


Lease Name Rehn Well # 1

Field Name

Producing Formation

Elevation: Ground 1921 1929 KB

Section Plat

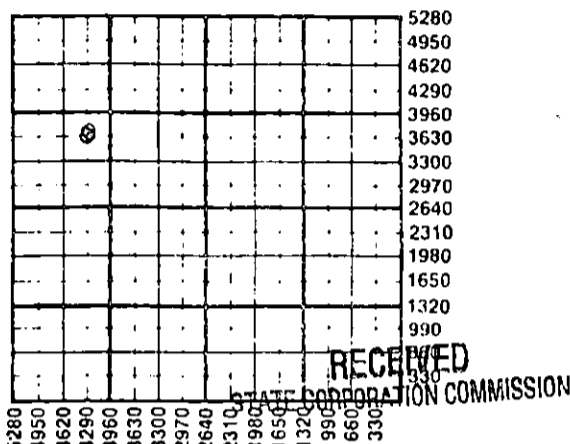

WATER SUPPLY INFORMATION

Disposition of Produced Water: Disposal
Docket # Wichita, Kansas

Questions on this portion of the ACO-1 call:

Water Resources Board (913) 296-3717

Source of Water: T88-621
Division of Water Resources Permit #

Groundwater Ft North from Southeast Corner (Well) Ft West from Southeast Corner of Sec Twp Rge East West

Surface Water Ft North from Southeast Corner (Stream, pond etc) Ft West from Southeast Corner Sec Twp Rge East West

Other (explain) (purchased from city, R.W.D. #)

INSTRUCTIONS: This form shall be completed in triplicate and filed with the Kansas Corporation Commission, 200 Colorado Derby Building, Wichita, Kansas 67202, within 120 days of the spud date of any well. Rule 82-3-130, 82-3-107 and 82-3-106 apply. Information on side two of this form will be held confidential for a period of 12 months if requested in writing and submitted with the form. See rule 82-3-107 for confidentiality in excess of 12 months. One copy of all wireline logs and drillers time log shall be attached with this form. Submit CP-4 form with all plugged wells. Submit CP-111 form with all temporarily abandoned wells.

All requirements of the statutes, rules and regulations promulgated to regulate the oil and gas industry have been fully complied with and the statements herein are complete and correct to the best of my knowledge.

Signature Alan D. Banta
Title Vice President Date 12/28/88

Subscribed and sworn to before me this 28th day of December 1988
Notary Public Sondra J. Follis
Date Commission Expires May 13, 1991

K.C.C. OFFICE USE ONLY
F Letter of Confidentiality Attached
C Wireline Log Received
C Drillers Timelog Received
Distribution
KCC SWD/Rep NGPA
KGS Plug Other (Specify)
12-29-88
Form ACO-1 (5-86)

Sec. 10 Twp. 21 Rge. 14 W

Operator Name Trans Pacific Oil Corporation Lease Name Rehn Well # 1

Sec. 10 Twp. 21 Rge. 14 East West County Stafford

WELL LOG

INSTRUCTIONS: Show important tops and base of formations penetrated. Detail all cores. Report all drill stem tests giving interval tested, time tool open and closed, flowing and shut-in pressures, whether shut-in pressure reached static level, hydrostatic pressures, bottom hole temperature, fluid recovery, and flow rates if gas to surface during test. Attach extra sheet if more space is needed. Attach copy of log.

Drill Stem Tests Taken Yes No
 Samples Sent to Geological Survey Yes No
 Cores Taken Yes No

Formation Description
 Log Sample

		Name	Top	Bottom
DST #1 3481-3505 (Lans) 30-30-30-30 Wk Blo Died No blo 2nd Finished, no help. Rec. 65' DM (Spks O) ISIP 631# FSIP 602# IFP 50-54# FFP 64-644#		Anhy.	805	(+1124)
		HB	3243	(-1314)
		Brrn Lm	3358	(-1429)
		Lans	3371	(-1442)
		BKC	3616	(-1687)
		Viola Chert	3616	(-1687)
DST #2 3610-3660 (Viola) 30-30-30-30 Wk Blo, Died Rec: 10' M ISIP 26# FSIP 24# IFP 20-22# FFP 22-22#		Simp Sh	3655	(-1726)
		Simp Sd	3674	(-1745)
		Arb.	3712	(-1783)
		RTD	3742	(-1813)
DST #3 3646-3695 (Simp.) 20-20-20-20 Wk Blo, Died Rec: 5' M ISIP 52# FSIP 46# IFP 36-36# FFP 40-40#				

CASING RECORD <input type="checkbox"/> New <input type="checkbox"/> Used Report all strings set-conductor, surface, intermediate, production, etc.							
Purpose of String	Size Hole Drilled	Size Casing Set (In O.D.)	Weight Lbs/Ft.	Setting Depth	Type of Cement	#Sacks Used	Type and Percent Additives
Surface Pipe		8 5/8	20#	370'	60/40	200	3% CC 2% GEL
PERFORATION RECORD				Acid, Fracture, Shot, Cement Squeeze Record			
Shots Per Foot	Specify Footage of Each Interval Perforated			(Amount and Kind of Material Used)		Depth	
TUBING RECORD				Liner Run <input type="checkbox"/> Yes <input type="checkbox"/> No			
Date of First Production		Producing Method <input type="checkbox"/> Flowing <input type="checkbox"/> Pumping <input type="checkbox"/> Gas Lift <input type="checkbox"/> Other (explain).....					
Estimated Production Per 24 Hours	Oil	Gas	Water	Gas-Oil Ratio	Gravity		
	Bbls	MCF	Bbls	CFPB			

METHOD OF COMPLETION

Production Interval

Disposition of gas: Vented Open Hole Perforation
 Sold Other (Specify)
 Used on Lease Dually Completed
 Commingled

Trans Pacific Oil Corporation
410 One Main Place
Wichita, Kansas 67202

DRILLERS LOG

1 Rehn
NE SW NW 10-21S-14W
Stafford County
Kansas

Spud Date: 12-12-88
Comp. Date: 12-19-88

0-805'	Soil, Sand Streaks
805-845'	Anhydrite
845-1535'	Shale
1535-2300'	Shale & Lime
2300-3110'	Shale & Lime
3110-3505'	Shale & Lime
3505-3660'	Shale & Lime
3660-3717'	Shale & Lime
3717-3742'	Shale
3742-	T.D.

Surface Pipe: Ran 12 jts new 8 5/8" 20# Set @370'
Cemented w/200 SXS 60/40 POZ 3% CC 2% GEL

Plugging: 1st Plug @3740' w/25 SXS
2nd Plug @850' w/50 SXS
3rd Plug @400' w/50 SXS
Top Plug @40' w/10 SXS to surface
10 SXS in Water Well

RECEIVED
STATE CORPORATION COMMISSION

DEC 29 1988

CONSERVATION DIVISION
Wichita, Kansas

AFFIDAVIT


STATE OF KANSAS
COUNTY OF SEDGWICK

Alan D. Banta of lawful age does swear and state that the facts and statements herein are true and correct to the best of his knowledge.


Alan D. Banta

Subscribed and sworn to before me this 28TH day of December 19 88

My Commission Expires:

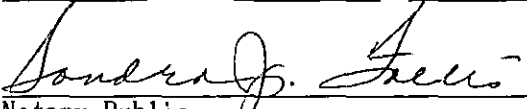
Notary Public
Sondra J. Follis

May 13, 1991