

STATE OF KANSAS
STATE CORPORATION COMMISSION


Form CP-4

Give All Information Completely
Make Required Affidavit
Mail or Deliver Report to:
Conservation Division
State Corporation Commission
212 No. Market
Wichita, Kansas

WELL PLUGGING RECORD

Stafford County, Sec. 4 Twp. 21S Rge. 14 (E) W (W)

Location as "NE/CNW/SW" or footage from lines NE NE NE
Lease Owner Frank J. Black
Lease Name Langer Well No. 2
Office Address McPherson, Kansas
Character of Well (completed as Oil, Gas or Dry Hole) Oil
Date well completed 1-5-54 19
Application for plugging filed 5-25-66 19
Application for plugging approved 5-26-66 19
Plugging commenced 6-6-66 19
Plugging completed 6-7-66 19
Reason for abandonment of well or producing formation Depleted.

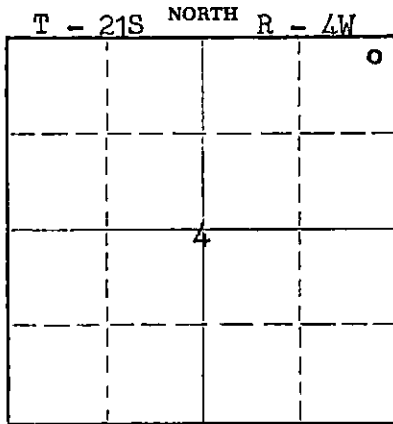

Locate well correctly on above Section Plat

If a producing well is abandoned, date of last production _____ 19____
Was permission obtained from the Conservation Division or its agents before plugging was commenced? yes

Name of Conservation Agent who supervised plugging of this well Archie Elving
Producing formation _____ Depth to top _____ Bottom _____ Total Depth of Well 3567 Feet
Show depth and thickness of all water, oil and gas formations.

OIL, GAS OR WATER RECORDS				CASING RECORD		
FORMATION	CONTENT	FROM	TO	SIZE	PUT IN	PULLED OUT
				8-5/8"	807'	None
				5-1/2"	3563 1/2'	3065'

Describe in detail the manner in which the well was plugged, indicating where the mud fluid was placed and the method or methods used in introducing it into the hole. If cement or other plugs were used, state the character of same and depth placed, from _____ feet to _____ feet for each plug set.

Checked hole to 3567', sanded hole to 3550' and dumped 5 sacks of cement @ 3550' with dump bailer. Pulled 5 1/2" casing, set rock bridge @ 300' and dumped 25 sacks of cement. Mudded hole to 40', set rock bridge to 30' and ran 10 sacks of cement to base of cellar.

PLUGGING COMPLETE.

1-27
STATE CORPORATION COMMISSION
JUN 15 1966
CONSERVATION DIVISION
Wichita, Kansas

(If additional description is necessary, use BACK of this sheet)
Name of Plugging Contractor KNIGHT CASING PULLING COMPANY License # 436
Address CHASE, KANSAS

STATE OF KANSAS, COUNTY OF RICE, ss.
Noel J. Knight (employee of owner) or (owner/contractor) of the above-described well, being first duly sworn on oath, says: That I have knowledge of the facts, statements, and matters herein contained and the log of the above-described well as filed and that the same are true and correct. So help me God.

(Signature) Noel J. Knight
Chase, Kansas
(Address)

SUBSCRIBED AND SWORN to before me this 10th day of June, 1966

My commission expires May 20, 1968

Milton J. John
Notary Public.

MILLER'S LOG LANGER #2

Darrah & Garvin, Operator

Section 4, Twp. 21S, Rge. 11W

Garvey Drilling Company, Contractor

Location: NE NE NE

Drilling Commenced: December 24, 1953.

County: Stafford County, Kansas

Drilling Completed: January 5, 1954.

Production: Arbuckle

Casing Record: 8-5/8" @ 807' w/500 sax
5-1/2" @ 3563 1/2 w/70 sax

R.T.D.: 3567'

Figures below indicate bottom of formation:

- 260 Sand & Shale
- 330 Sand
- 470 Shale & Shells
- 765 Red Bed & Shale
- 802 Red Bed
- 830 Anhydrite
- 1370 Red Bed & Shale
- 1715 Shale & Shells
- 1895 Lime
- 2205 Lime & Shale
- 2410 Shale
- 2655 Shale & Shells
- 2700 Shale
- 2770 Lime
- 3032 Shale & Lime
- 3221 Lime
- 3297 Shale & Lime
- 3567 Lime

- 3567 R.T.D.

RECEIVED
STATE CORPORATION COMMISSION

JUN 15 1966

CONSERVATION DIVISION
Wichita, Kansas

I hereby certify that this is a true and correct log of the above mentioned well.

GARVEY DRILLING COMPANY

By W. W. T. [Signature]

STATE OF KANSAS)
) SS:
COUNTY OF SEDGWICK)

Subscribed to and sworn to before me, a Notary Public, in said County and State, this 9th day of January, 1954.

[Signature]
Notary Public

My commission expires: October 13, 1954.