


STATE OF KANSAS  
STATE CORPORATION COMMISSION

WELL PLUGGING RECORD

Give All Information Completely  
Make Required Affidavit  
Mail or Deliver Report to:  
Conservation Division  
State Corporation Commission  
211 No. Broadway  
Wichita, Kansas

Stafford County. Sec. 10 Twp. 21S Rge. 14W ~~NE~~ (W)  
Location as "NE/CNW%SW%" or footage from lines C S/2 S/2 SE  
Lease Owner H. L. Herbel  
Lease Name Anschutz Well No. 1  
Office Address Box 327, Chase, Kansas  
Character of Well (completed as Oil, Gas or Dry Hole) Dry Hole  
Date well completed January 15 1966  
Application for plugging filed January 15 1966  
Application for plugging approved January 15 1966  
Plugging commenced January 15 1966  
Plugging completed January 15 1966  
Reason for abandonment of well or producing formation Dry Hole

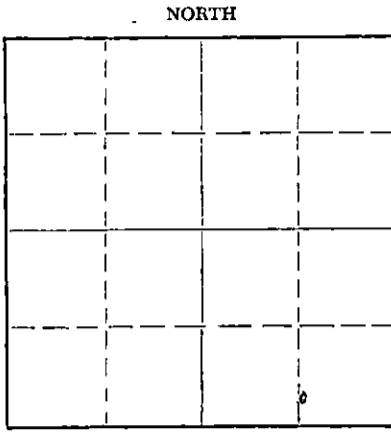

Locate well correctly on above  
Section Plat

If a producing well is abandoned, date of last production \_\_\_\_\_ 19\_\_\_\_  
Was permission obtained from the Conservation Division or its agents before plugging was com-  
menced? yes

Name of Conservation Agent who supervised plugging of this well Archie Elving  
Producing formation \_\_\_\_\_ Depth to top \_\_\_\_\_ Bottom \_\_\_\_\_ Total Depth of Well \_\_\_\_\_ Feet  
Show depth and thickness of all water, oil and gas formations.

OIL, GAS OR WATER RECORDS

CASING RECORD

FORMATION	CONTENT	FROM	TO	SIZE	PUT IN	PULLED OUT

Describe in detail the manner in which the well was plugged, indicating where the mud fluid was placed and the method or methods used in introducing it into the hole. If cement or other plugs were used, state the character of same and depth placed, from \_\_\_\_\_ feet to \_\_\_\_\_ feet for each plug set.

Bottom plug 275' with 1/2 sack hulls 25 sacks  
cement down drill pipe. Mud to 40' plug and  
1/2 sack hulls held kelly up 10 sacks cement  
2 sacks rat hole.

RECEIVED  
STATE CORPORATION COMMISSION

JAN 21 1966

(If additional description is necessary, use BACK of this sheet)

Name of Plugging Contractor ISERN DRILLING COMPANY  
Address BOX 486, ELLINWOOD, KANSAS

STATE OF KANSAS, COUNTY OF BARTON, ss.  
W. F. Banks (employee of owner) or (~~owner or operator~~) of the above-described well, being first duly sworn on oath, says: That I have knowledge of the facts, statements, and matters herein contained and the log of the above-described well as filed and that the same are true and correct. So help me God.

(Signature) W. F. Banks

Box 486, Ellinwood, Kansas  
(Address)

SUBSCRIBED AND SWORN TO before me this 20th day of January 1966

My commission expires February 10, 1967.

George A. Meyer  
George A. Meyer Notary Public.

W E L L L O G

H. L. Herbel, ANSCHUTZ #1  
 C S/2 S/2 SE, Section 10-21S-14W  
 Stafford County, Kansas

ELEVATION: 1933' KB.

Figures indicate bottom of formation:

PIPE RECORD:  
 8 5/8" set @ 310'  
 with 225 sacks of cement.

ROTARY COMMENCED: 1- 6-66  
 ROTARY COMPLETED: 1-15-66

TOPS:

Heebner 3238  
 Brown Lime 3354  
 Lansing 3366  
 Viola 3612  
 Simpson Sand 3691  
 Azbuckle 3718

0	to	10	cellar
		220	sand
		310	shale & shale
		1215	shale
		1735	shale & shells
		2185	lime & shale
		2520	shale & shells
		2630	lime & shale
		2880	shale & lime
		3600	lime & shale
		3660	lime & chert
		3725	lime & shale
		3726	Rotary Total Depth

**RECEIVED**  
 STATE CORPORATION COMMISSION

JAN 21 1966

CONSERVATION DIVISION  
 Wichita, Kansas

STATE OF KANSAS )  
 COUNTY OF BARTON ) ss

I, W. F. Banks, Drilling Superintendent for Isern Drilling Company, contractor for the above-described well, being first duly sworn on oath, declare: That I have knowledge of the facts, statements and matter herein contained pertaining to the log of the above-described well, as filed, and that the same are true and correct.

W. F. Banks  
 W. F. Banks

Subscribed and sworn to before me on this 20th day of January, 1966.

My commission expires: 2-10-67. George A. Meyer  
 George A. Meyer Notary Public