


Give All Information Completely  
Make Required Affidavit  
Mail or Deliver Report to:  
Conservation Division  
State Corporation Commission  
211 No. Broadway  
Wichita, Kansas

WELL PLUGGING RECORD

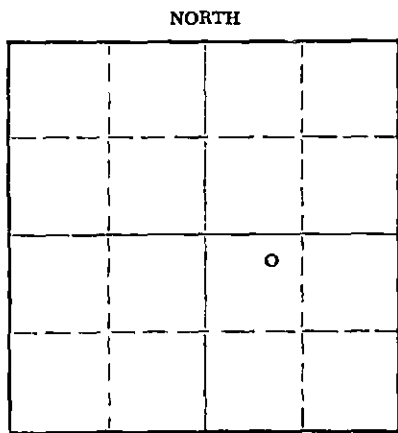

Locate well correctly on above  
Section Plat

Stafford County, Sec. 10 Twp. 21S Rge. 14W (E) (W)  
Location as "NE/CNW/SW" or footage from lines NE NW SE  
Lease Owner J. C. Musgrove, Inc.  
Lease Name Anschutz Well No. 1  
Office Address 1314 Kansas Avenue, Great Bend, Kansas 67530  
Character of Well (completed as Oil, Gas or Dry Hole) Dry Hole  
Date well completed April 11 19 71  
Application for plugging filed April 11 19 71  
Application for plugging approved April 11 19 71  
Plugging commenced April 11 19 71  
Plugging completed April 11 19 71  
Reason for abandonment of well or producing formation Dry Hole

If a producing well is abandoned, date of last production \_\_\_\_\_ 19 \_\_\_\_  
Was permission obtained from the Conservation Division or its agents before plugging was commenced? Yes

Name of Conservation Agent who supervised plugging of this well G. R. Biberstein, Attica, Kansas  
Producing formation \_\_\_\_\_ Depth to top \_\_\_\_\_ Bottom \_\_\_\_\_ Total Depth of Well 3750 Feet  
Show depth and thickness of all water, oil and gas formations.

OIL, GAS OR WATER RECORDS

CASING RECORD

FORMATION	CONTENT	FROM	TO	SIZE	PUT IN	PULLED OUT
		0	357'	8 5/8"	357'	None

Describe in detail the manner in which the well was plugged, indicating where the mud fluid was placed and the method or methods used in introducing it into the hole. If cement or other plugs were used, state the character of same and depth placed, from \_\_\_\_\_ feet to \_\_\_\_\_ feet for each plug set.

Plug: 600'/50 sacks cement  
325'/25 sacks cement  
40'/40 sacks cement

RECEIVED  
STATE CORPORATION COMMISSION  
APR 16 1971  
CONSERVATION DIVISION  
Wichita, Kansas

(If additional description is necessary, use BACK of this sheet)  
Name of Plugging Contractor Hellar Drilling Company, Inc.  
Address 339 Union Center Bldg., Wichita, Kansas 67202

STATE OF Kansas COUNTY OF Sedgwick, ss.  
D. L. Hellar, Pres. of Hellar Drilling Co. Inc. (employee of owner) or (owner or operator) of the above-described well, being first duly sworn on oath, says: That I have knowledge of the facts, statements, and matters herein contained and the log of the above-described well as filed and that the same are true and correct. So help me God.  
(Signature) [Signature] D. L. Hellar, President  
339 Union Center Bldg., Wichita, Kansas 67202  
(Address)



Sworn to before me this 15th day of April, 19 71  
My commission expires March 25, 1972.  
Catherine Darcey  
Catherine Darcey - Notary Public.

DRILLER'S LOG

COMPANY: J. C. Musgrove, Inc., 1314 Kansas Avenue, Great Bend, Kansas 67530  
 CONTRACTOR: Hellar Drilling Company, Inc., Wichita, Kansas 67202  
 LEASE: #1 Anschutz  
 LOCATION: NE NW SE 10-21S-14W, Stafford County, Kansas  
 COMMENCED: March 31, 1971  
 COMPLETED: April 11, 1971  
 CASING: Set 8 5/8" Surface Casing @ 357' w/325 sacks cement

0-30	Clay
30-225	Sand
225-358	Shale & Sand
358-826	Shale & Red Bed
826-851	Anhydrite
851-1540	Shale & Red Bed
1540-1650	Shale
1650-1825	Shale & Lime
1825-1965	Salt Section & Lime
1965-3205	Lime & Shale
3205-3346	Lime
3346-3358	Shale & Lime
3358-3698	Lime
3698-3705	Lime & Shale
3705-3729	Arbuckle
3729-3750	Lime
3750	Rotary Total Depth

D &amp; A

RECEIVED  
 STATE CORPORATION COMMISSION  
 APR 16 1971  
 CONSERVATION DIVISION  
 Wichita, Kansas

STATE OF KANSAS ))  
 ) SS  
 COUNTY OF SEDGWICK )

I, D. L. Hellar, do hereby certify that the above and foregoing is a true and correct copy of the log of the #1 Anschutz, located in NE NW SE 10-21S-14W, Stafford County, Kansas, as reflected by the files of the Hellar Drilling Company, Inc.

HELLAR DRILLING COMPANY, INC.

By *D. L. Hellar*  
 President - D. L. Hellar

Subscribed and sworn to before me, a Notary Public, in and for Sedgwick County, Kansas, this 15th day of April, 1971.

*Catherine Darcey*  
 Notary Public - Catherine Darcey

My Commission Expires:  
 March 25, 1972.