


STATE OF KANSAS  
 STATE CORPORATION COMMISSION  
 CONSERVATION DIVISION  
 P. O. BOX 17027  
 WICHITA, KANSAS 67217

FORM CP-4

WELL PLUGGING RECORD

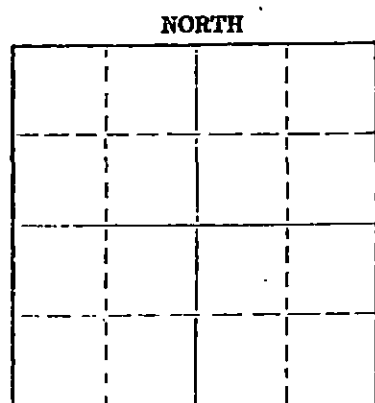

Locate well correctly on above Section Plat

Stafford County, Sec 10 Twp 21S Rge 14W (E) (W)  
 Location as "NE/CNWKSW¼" or footage from lines 750 FNL 1020 FEL NW¼  
 Lease Owner Murfin Drilling Company  
 Lease Name Rehn Well No. 1  
 Office Address 617 Union Center, Wichita, Kansas 67202  
 Character of Well (completed as Oil, Gas or Dry Hole) Dry Hole  
 Date well completed 2-18 19 76  
 Application for plugging filed 2-18 19 76  
 Application for plugging approved 2-18 19 76  
 Plugging commenced 2-18 19 76  
 Plugging completed 2-18 19 76  
 Reason for abandonment of well or producing formation Dry Hole

If a producing well is abandoned, date of last production 19  
 Was permission obtained from the Conservation Division or its agents before plugging was commenced? Yes

Name of Conservation Agent who supervised plugging of this well G. Russell Bieberstein  
 Producing formation Depth to top Bottom Total Depth of Well 3690 Feet  
 Show depth and thickness of all water, oil and gas formations.

OIL, GAS OR WATER RECORDS

CASING RECORD

FORMATION	CONTENT	FROM	TO	SIZE	PUT IN	PULLED OUT
				8-5/8	361'	-

Describe in detail the manner in which the well was plugged, indicating where the mud fluid was placed and the method or methods used in introducing it into the hole. If cement or other plugs were used, state the character of same and depth placed, from feet to feet for each plug set.

Mud to 360', 35 sacks cement  
 Mud to 40', plug, 1/4 sack hulls  
 and 15 sacks cement  
 5 sacks cement in rat hole

RECEIVED  
 STATE CORPORATION COMMISSION

FEB 26 1976

CONSERVATION DIVISION  
 WICHITA, KANSAS

Name of Plugging Contractor \_\_\_\_\_ (If additional description is necessary, use BACK of this sheet)  
 Address \_\_\_\_\_ 2-26-1976

STATE OF KANSAS COUNTY OF SEDGWICK ss.  
 Don Gardner (employee of owner) of the above-described well, being first duly sworn on oath, says: That I have knowledge of the facts, statements, and matters herein contained and the log of the above-described well as filed and that the same are true and correct. So help me God.

(Signature) \_\_\_\_\_  
 Suite 250, 200 W. Douglas, Wichita, Kansas  
 (Address)

SUBSCRIBED AND SWORN TO before me this 23rd day of February 19 76

My commission expires March 1, 1978 \_\_\_\_\_ Notary Public.

DRILLERS LOG

REHN #1  
750 FNL 1020 FEL NW $\frac{1}{4}$   
Sec. 10-21S-14W  
Stafford County, Kansas

OPERATOR: Murfin Drilling Company  
617 Union Center  
Wichita, Kansas 67202

CONTRACTOR: Dunne-Gardner Petroleum, Inc.  
Suite 250, 200 West Douglas  
Wichita, Kansas 67202

COMMENCED: February 9, 1976

COMPLETED: February 18, 1976

CASING RECORD: 8-5/8" @ 361' w/310 sx

<u>FROM</u>	<u>TO</u>	<u>DESCRIPTION</u>
0	200	Sand
200	280	Blue shale
280	330	Sand
330	361	Blue shale
361	687	Sand and red bed
687	831	Shale
831	846	Anhydrite
846	1710	Shale and shells
1710	3054	Shale and lime
3054	3070	Lime
3070	3405	Shale and lime
3405	3470	Lime and chert
3470	3597	Lime
3597	3690	Lime and chert
3690		Rotary total depth

RECEIVED  
STATE COOPERATION COMMISSION

FEB 26 1976

CONSERVATION DIVISION  
Wichita, Kansas


STATE OF KANSAS )  
                          ) ss  
COUNTY OF SEDGWICK)

I hereby certify that the above is a true and correct log to the best of my knowledge and belief.

  
Don Gardner

Subscribed and sworn to before me this 23rd day of February, 1976.

My commission expires:  
March 1, 1978

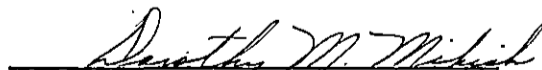  
Notary Public