


STATE OF KANSAS
STATE CORPORATION COMMISSION
200 Colorado Derby Bldg.
Wichita, Kansas 67202

Form CP-4
Rev. 12-15-80

WELL PLUGGING RECORD

Give All Information Completely
Make Required Affidavit

COUNTY Stafford SEC. 10 TWP. 21S RGE. 14W E/W
Location as in quarters or footage from lines:
50'E of SE NE NW

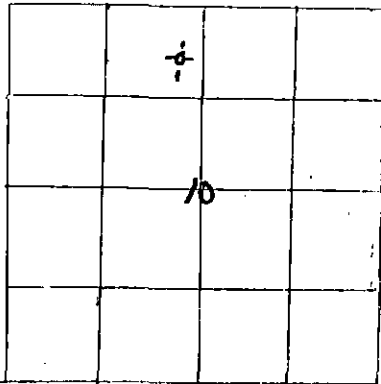

Lease Owner Alpine Drilling Co., Inc.
Lease Name REHN Well No. 1
Office Address 200 E. First, Suite 500, Wichita, KS 67202
Character of Well (Completed as Oil, Gas or Dry Hole): Dry Hole
Date Well Completed September 22, 1982
Application for plugging filed September 22, 1982
Plugging commenced September 22, 1982
Plugging completed September 22, 1982
Reason for abandonment of well or producing formation _____

Locate Well
correctly on above
Section Platt.

Was permission obtained from the Conservation Division or it's
Agent's before plugging was commenced? yes

Name of Conservation Agent who supervised plugging of this well Steve Durrant
Producing formation _____ Depth to top _____ bottom _____ T.D. 3705
Show depth and thickness of all water, oil and gas formations.

OIL, GAS OR WATER RECORDS

Casing Record

Formation	Content	From	To	Size	Put in	Pulled Out
Surface	shale	0	361	8-5/8"	358'	none
	cemented with 300 plug down at 6:45		sx common, 2% p.m. 9-16-82	gel, 3% cc, by Sun.		

Describe in detail the manner in which the well was plugged, indicating where the mud
fluid was placed and the method or methods used in introducing it into the hold. If cement
or other plugs were used, state the character of same and depth placed, from _____ feet
to _____ feet for each plug set.

Plugged as follows with 100 sx 50/50 posmix, 4% gel, 3% cc
35sx @ 840'
40sx @ 360'
10sx with solid bridge plug @ 40'
10 sx in rat hole, 5 sx in water well
job completed at 3 p.m. 9-22-82 by Sun

(If additional description is necessary, use BACK of this sheet)

Name of Plugging Contractor J.W. Drilling Co., Inc.

STATE OF KANSAS COUNTY OF SEDGWICK, ss.
Jon T. Williams, Jr. (employee of owner) or (owner or operator) of the
above-described well, being first duly sworn on oath, says: That I have knowledge of the
facts, statements, and matters herein contained and the log of the above-described well as
filed and that the same are true and correct. So help me God.

(Signature) [Signature]
200 East First, Suite 500, Wichita, KS
(Address)



SUBSCRIBED AND SWORN TO before me this 22nd day of September, 1982

Geraldine Stewart
Geraldine Stewart Notary Public.

RECEIVED
SEP 24 1982

Witnesses: January 14, 1985

CONSERVATION DIVISION
Wichita, Kansas