


WELL PLUGGING RECORD

Give All Information Completely  
Make Required Affidavit  
Mail or Deliver Report to:  
Conservation Division  
State Corporation Commission  
800 Biting Building  
Wichita, Kansas

Stafford County. Sec. 15 Twp. 21 Rge. 14 (E) (W)  
Location as "NE/CNW/SW" or footage from lines SE SW NW  
Lease Owner THE EL DORADO REFINING COMPANY  
Lease Name TAYLOR Well No. 1  
Office Address BOX 209 RUSSELL, KANSAS  
Character of Well (completed as Oil, Gas or Dry Hole) Oil  
Date well completed September 28 1955  
Application for plugging filed April 19 1956  
Application for plugging approved April 20 1956  
Plugging commenced May 2 1956  
Plugging completed May 7 1956  
Reason for abandonment of well or producing formation: Insufficient Production

NORTH

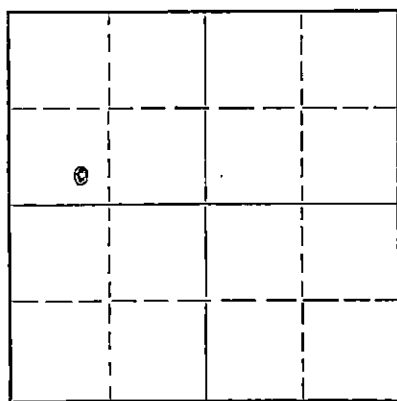

Locate well correctly on above  
Section Plat

If a producing well is abandoned, date of last production May 1 1956  
Was permission obtained from the Conservation Division or its agents before plugging was commenced? yes

Name of Conservation Agent who supervised plugging of this well Warren H. Horner-Box 207- Great Bend, Kansas  
Producing formation Arbuckle Depth to top 3741 Bottom 8 Total Depth of Well 3755 Feet  
Show depth and thickness of all water, oil and gas formations.

OIL, GAS OR WATER RECORDS

CASING RECORD

FORMATION	CONTENT	FROM	TO	SIZE	PUT IN	PULLED OUT
				8 5/8	263'	None
				5 1/2	3755'	3114.60'

Describe in detail the manner in which the well was plugged, indicating where the mud fluid was placed and the method or methods used in introducing it into the hole. If cement or other plugs were used, state the character of same and depth placed, from \_\_\_\_\_ feet to \_\_\_\_\_ feet for each plug set.

Filled hole with sand to 3700' Run 5 sacks of cement at 3700'

Pumped 15 sacks of mud and 2 sacks of hulls. Pumped 90 sacks of  
of cement, mudded to 35' Run 10 sacks of cement to cap.

(If additional description is necessary, use BACK of this sheet)

Name of Plugging Contractor C. E. Shull Casing Pulling Company  
Address Box 558 Great Bend, Kansas

STATE OF KANSAS, COUNTY OF RUSSELL, ss.  
LEVI B. SHERMAN (employee of owner) or (owner or operator) of the above-described

well, being first duly sworn on oath, says: That I have knowledge of the facts, statements, and matters herein contained and the log of the above-described well as filed and that the same are true and correct. So help me God.

(Signature) Levi B. Sherman  
Box 209 Russell, Kansas  
(Address)

SUBSCRIBED AND SWORN to before me this 14th day of May, 1956

Carol Jo Millerger Notary Public.  
RECEIVED  
STATE CORPORATION COMMISSION

My commission expires 5-9-59

24-7366-S 3-53-20M

**PLUGGING**  
FILE SEC. 15 TWP. 21 R. 14  
BOOK PAGE 55 LINE 16

MAY 15 1956  
CONSERVATION DIVISION-  
WICHITA, KANSAS  
5-15-1956

15.185.00657.0000

#1 Taylor, Electric Log. Tops (1933) D.F.

Hb'	3261
Tor	3289
Br. Lm	3379
Lans.	3390
B/KC	3625
Congl.	3637
Vio	3645
Sm/Sh	3695
"/Sd	3711
Arb.	3743
T.D.	3755

STERLING DRILLING COMPANY

Sterling, Kansas

WELL LOG----- Taylor #1

Location: SE SW 1/4 Section 15-21s-14w  
Stafford County, Kansas

Owner: The El Dorado Refining Company  
Rotary Drilling Contractor: Sterling Drilling Company

Commenced: 8-18-55 (w.r.)  
Completed: 8-30-55 (w.r.)

Total Depth: 3758'

LOG

CASING RECORD

0-267	Sand & Shale
267-300	Shale & Red Bed
300-600	Sand
600-890	Shale
890-910	Anhydrite
910-1600	Shale & Red Bed
1600-2400	Limestone
2400-3195	Shale & Limestone
3195-3310	Limestone
3310-3335	Shale & Limestone
3335-3560	Limestone
3560-3670	Limestone & Shale
3670-3710	Limestone
3710-3721	Shale
3721-3758	Limestone T.D.

Ran 263' of 8 5/8" Casing, cement  
ed with 200 sacks cement and 2  
sacks Calcium Chloride

Set 5 1/2" Casing at 3755' with  
100 sacks cement.

**PLUGGING**  
 FILE SEC 15 T 21 R 14w  
 BOOK PAGE 55 LINE 16