

15.185.00041.0000


STATE OF KANSAS
STATE CORPORATION COMMISSION

WELL PLUGGING RECORD

Give All Information Completely
Make Required Affidavit
Mail or Deliver Report to:
Conservation Division
State Corporation Commission
800 Bittling Building
Wichita, Kansas

Stafford County. Sec. 15 Twp. 21S Rge. 14 ~~XXX~~ W(W)

Location as "NE/CNW/SW" or footage from lines NE/4 NE/4 NW/4
Lease Owner Stanolind Oil and Gas Company
Lease Name T. R. Taylor Well No. 1
Office Address Box 1654, Oklahoma City, Oklahoma
Character of Well (completed as Oil, Gas or Dry Hole) Oil
Date well completed 12-29- 19 51
Application for plugging filed 4-4- 19 55
Application for plugging approved 4-5- 19 55
Plugging commenced 5-13- 19 55
Plugging completed 5-17- 19 55
Reason for abandonment of well or producing formation Depleted

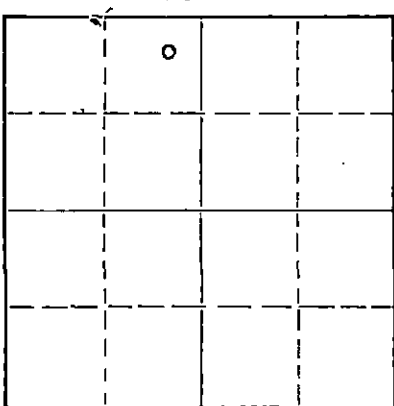

Locate well correctly on above
Section Plat

If a producing well is abandoned, date of last production 10-7- 19 54
Was permission obtained from the Conservation Division or its agents before plugging was commenced? Yes

Name of Conservation Agent who supervised plugging of this well M. A. Rives
Producing formation Simpson Depth to top 3648 Bottom 3708 Total Depth of Well 3741 Feet
Show depth and thickness of all water, oil and gas formations.

OIL, GAS OR WATER RECORDS

CASING RECORD

FORMATION	CONTENT	FROM	TO	SIZE	PUT IN	PULLED OUT
Arbuckle	Water	3708	3741	8-5/8	847	None
Iansing	Water	3373	3648	5-1/2	3744	3122
Simpson	Oil-Depleted	3648	3708			

Describe in detail the manner in which the well was plugged, indicating where the mud fluid was placed and the method or methods used in introducing it into the hole. If cement or other plugs were used, state the character of same and depth placed, from _____ feet to _____ feet for each plug set.

- Sand 3741-3670
- 5 Sx Cement 3670-3640
- Hvy Mud 3640- 300
- Rock Bridge 300- 285
- 20 Sx Cement 285- 225
- Hvy Mud 225- 35
- Rock Bridge 35- 25
- 10 Sx Cement 25- To Bottom of Celler

(If additional description is necessary, use BACK of this sheet)
Name of Plugging Contractor R & S Pipe Pulling Company
Address Ellinwood, Kansas

STATE OF KANSAS COUNTY OF BARTON
I, F. H. Butcher (employee of owner) or (owner or operator) of the above-described well, being first duly sworn on oath, says: That I have knowledge of the facts, statements, and matters herein contained and the log of the above-described well as filed and that the same are true and correct. So help me God.

(Signature) F. H. Butcher
P. O. Box 7, Ellinwood, Kansas
(Address)

SUBSCRIBED AND SWORN to before me this 20th day of May, 19 55

My commission expires November 12, 1958

NOTARY PUBLIC
STATE CORPORATION COMMISSION
MAY 23 1955
CONSERVATION DIVISION
Wichita, Kansas

PLUGGING
WELLS SEC 15 T 21 R 14W
BOOK PAGE 109 LINE 2

FORMATION RECORD

DESCRIBE EACH FORMATION DRILLED. INDICATE THICKNESS, CONTENT AND WHETHER DRY, OR OIL, GAS, OR WATER BEARING.

FORMATION	TOP	BOTTOM	FORMATION	TOP	BOTTOM
Surface Sand	0	100			
Sand, shale	100	215			
Sand	215	365			
Sand, shale, shells	365	480			
Red bed, shale	480	825			
Red bed, sand	825	848			
Anhydrite	848	858			
Shale	858	910			
Shale, shells	910	1856			
Shale, lime	1856	1945			
Lime	1945	2025			
Lime, sand	2025	2055			
Lime, shale	2055	2580			
Shale, shell	2580	2745			
Lime, shale	2745	3150			
Lime	3150	3237			
Heebner Top	3237				
Lime	3237	3367			
Lime, shale	3367	3373			
Lansing Top	3373				
Lime, shale	3373	3443			
Lime, salt water	3443	3495			
Lime, shale, oilspecks	3495	3610			
Cherty conglomeration	3610	3648			
Simpson Top	3648				
Lime, shale, oil shows	3648	3692			
Lime	3692	3708			
Arbuckle Top	3708				
dolomite lime, oil shows	3708				
Ran Schlumberger Elec. Logs to TD					
<u>Total Depth</u>					
By Schlumberger		3708			
By Rotary Drill		3708			
5 1/2" OD casing set @ w/100 sx		3708			
Drilled w/cable tools sandy lime, water, no show	3708	3741 TD			
Set Lane Wells plug dumped sx cement to plug back to		3700			
Perforated w/36 Lane Well shots	3682	3688			
<u>Test</u>					
24 hr. swabbing, 3 BOPH, no water					
Completed in the Simpson formation at plugged back depth Dec. 29, 1951		3700			