


STATE OF KANSAS
STATE CORPORATION COMMISSION

WELL PLUGGING RECORD

Give All Information Completely
Make Required Affidavit
Mail or Deliver Report to
Conservation Division
State Corporation Comm.
245 North Water
Wichita, KS 67202

Stafford County, Sec. 15 Twp. 21S Rge. 14W E/W
Location as "NE/CNW $\frac{1}{4}$ SW $\frac{1}{4}$ " or footage from lines
SE NW SW

Lease Owner Graves Drilling Co., Inc.
Lease Name Grampe Well No. 2
Office Address 910 Union Center Wichita, Kansas 67202
Character of Well (Completed as Oil, Gas or Dry Hole)
Dry Hole

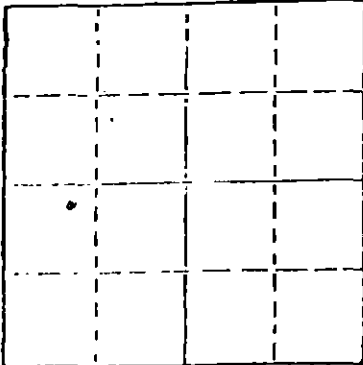

Locate well correctly on above
Section Plat

Date Well completed 12-6-80 19
Application for plugging filed 12-6-80 19
Application for plugging approved 12-6-80 19
Plugging commenced 12-6-80 19
Plugging completed 12-7-80 19
Reason for abandonment of well or producing formation

If a producing well is abandoned, date of last production 19

Was permission obtained from the Conservation Division or its agents before plugging was commenced? Yes

Name of Conservation Agent who supervised plugging of this well Duane L. Rankin
Producing formation Depth to top Bottom Total Depth of Well 3270'
Show depth and thickness of all water, oil and gas formations.

OIL, GAS OR WATER RECORDS

CASING RECORD

| FORMATION | CONTENT | FROM | TO | SIZE | PUT IN | PULLED OUT |
|-----------|---------|------|----|------|--------|------------|
| | | | | | | |
| | | | | | | |
| | | | | | | |
| | | | | | | |

Describe in detail the manner in which the well was plugged, indicating where the mud fluid was placed and the method or methods used in introducing it into the hold. If cement or other plugs were used, state the character of same and depth placed, from feet to feet for each plug set.

Mud To 470' 50 Sacks 50-50 Posmix 4 % Gel
Mud To 40' 10 Sacks 50-50 Posmix 4% Gel
Rat Hole 5 Sacks
Mouse Hole 5 Sacks

RECEIVED
STATE CORPORATION COMMISSION

(If additional description is necessary, use BACK of this Form)
Name of Plugging Contractor Merckle Drilling Co. Dec 15 1980

CONSERVATION DIVISION
Wichita, Kansas

STATE OF Kansas COUNTY OF Barton ss.
Clyde Merckle (employee of owner) or (owner or operator)
of the above-described well, being first duly sworn on oath, says: That I have knowledge of the facts, statements, and matters herein contained and the log of the above-described well as filed and that the same are true and correct. So help me God.

(Signature) Clyde Merckle
Box 1382 Great Bend, Kansas 67530
(Address)

SUBSCRIBED AND SWORN TO before me this 12th day of December, 1980

Notary Public.

My commission expires 3-28-84



Graves Drilling Co., Inc.
910 Union Center
Wichita, Kansas 67202

Krampe #2

SE NW SW

Section 15 Twp 21S Rge. 14W

Stafford County

Driller's Log _____ Total Depth 3770'

0-----250 Sand
250----293 Blue Shale
293----387 Sand
387----425 Red Bed
425---794 Shale
794----848 Shale
848----870 Anhydrite
870----1750 Shale
1750---2200 Lime & Shale
2200---2990 Lime & Shale
2990---3215 Lime & Shale
3215---3548 Lime
3548---3770 Lime


Clyde Merckle

RECEIVED
STATE CORPORATION COMMISSION
DEC 15 1980
CONSERVATION DIVISION
Wichita, Kansas