


STATE OF KANSAS  
STATE CORPORATION COMMISSION  
CONSERVATION DIVISION  
P. O. BOX 17027  
WICHITA, KANSAS 67217

WELL PLUGGING RECORD

Stafford County. Sec. 19 Twp. 21 Rge. (E) 12 (W)  
Location as "NE/CNW/SW" or footage from lines NE NE SW  
Lease Owner Poor Boy Corporation  
Lease Name Fischer Well No. 1  
Office Address Rt. #2, Ellinwood, Kansas 67526  
Character of Well (completed as Oil, Gas or Dry Hole) Dry Hole  
Date well completed Aug. 23 19 76  
Application for plugging filed Aug. 23 19 76  
Application for plugging approved Aug. 23 19 76  
Plugging commenced Aug. 23 19 76  
Plugging completed Aug. 23 19 76  
Reason for abandonment of well or producing formation Dry Hole

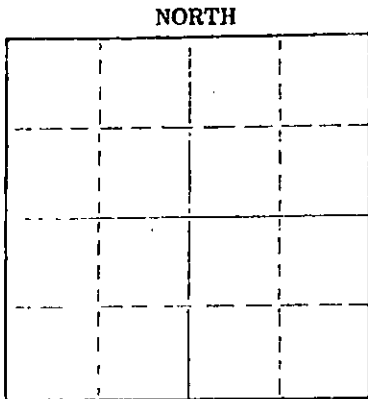

Locate well correctly on above Section Plat

If a producing well is abandoned, date of last production 19  
Was permission obtained from the Conservation Division or its agents before plugging was commenced? Yes

Name of Conservation Agent who supervised plugging of this well G. R. Biberstein  
Producing formation \_\_\_\_\_ Depth to top \_\_\_\_\_ Bottom \_\_\_\_\_ Total Depth of Well \_\_\_\_\_ Feet  
Show depth and thickness of all water, oil and gas formations.

OIL, GAS OR WATER RECORDS

CASING RECORD

FORMATION	CONTENT	FROM	TO	SIZE	PUT IN	PULLED OUT
				8 5/8	326	

Describe in detail the manner in which the well was plugged, indicating where the mud fluid was placed and the method or methods used in introducing it into the hole. If cement or other plugs were used, state the character of same and depth placed, from \_\_\_\_\_ feet to \_\_\_\_\_ feet for each plug set.

1st plug 300 w/35 sx.  
2nd plug 40 w/15 sx.

RECEIVED  
STATE CORPORATION COMMISSION

AUG 27 1976

CONSERVATION DIVISION  
Wichita, Kansas

(If additional description is necessary, use BACK of this sheet)  
Name of Plugging Contractor Woodman & Iannitti Drilling Co.  
Address 1008 Union National Bldg., Wichita, Kansas 67202

STATE OF KANSAS COUNTY OF SEDGWICK  
K. T. Woodman (employee of owner) or (owner or operator) of the above-described


well, being first duly sworn on oath, says: That I have knowledge of the facts, statements, and matters herein contained and the log of the above-described well as filed and that the same are true and correct. So help me God.

(Signature) K. T. Woodman  
1008 Union National Bldg.  
(Address)

Subscribed and sworn to before me this 26th day of August, 19 76

My commission expires Feb. 11, 1980

Justina Chamberlain  
Notary Public.

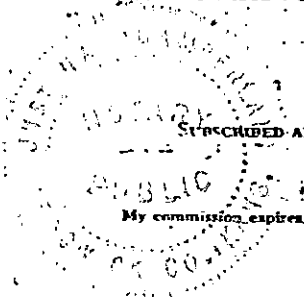

15.185.20678.0000

K. T. WOODMAN  
RES. PHONE 733-0418  
OFF. PHONE 265-7650  
WICHITA, KANSAS

D. J. IANNITTI  
PHONE 792-2921  
GREAT BEND, KANSAS

**WOODMAN & IANNITTI DRILLING COMPANY**  
*Rotary Drilling Contractors*

1008 UNION NATIONAL BUILDING  
WICHITA, KANSAS 67202

August 25, 1976

Company;	Poor Boy Corporation
Farm;	#1 Fischer
Location;	NE NE SW
Section;	19-21-12W
County;	Stafford
Comm;	August 16, 1976
Compl;	August 23, 1976
Contractor;	Woodman & Iannitti Drilling Co.
Total Depth;	3631'
Casing;	8 5/8" @ 326 with 250 sacks
Production;	D & A

Figures Indicate Bottom Of Formations:

240	Sand
250	Red Bed
326	Red Bed & Sand Streaks
550	Red Bed
700	Sand & shale
730	Anhy
1360	Shale & Shells
1525	Shale & Shells
1740	Shale & Lime
2015	Lime & Shale
2660	Lime & Shale
2785	Lime
3095	Lime & Shale
3200	Lime
3415	Lime & Shale
3585	Lime
3596	Arbuckle
3631	Arbuckle

RECEIVED  
STATE CORPORATION COMMISSION

AUG 27 1976

CONSERVATION DIVISION  
Wichita, Kansas

I certify the above to be a true and correct copy of the driller's log to the best of my knowledge and belief.

Woodman & Iannitti Drilling Co.

*K. T. Woodman*  
K. T. Woodman