


WELL PLUGGING RECORD

Give All Information Completely
Make Required Affidavit
Mail or Deliver Report to:
Conservation Division
State Corporation Commission
800 Bittling Building
Wichita, Kansas

Stafford County, Sec. 19 Twp 21S Rge. (E) 12 (W)

Location as "NE/CNW $\frac{1}{4}$ SW $\frac{1}{4}$ " or footage from lines SE SE NW
Lease Owner Magnolia Petroleum Company
Lease Name E. B. HALL Well No. 5
Office Address Box 900 Dallas, Texas
Character of Well (completed as Oil, Gas or Dry Hole) Dry
Date well completed July 13, 1954
Application for plugging filed July 14, 1954
Application for plugging approved July 15, 1954
Plugging commenced July 13, 1954
Plugging completed July 13, 1954
Reason for abandonment of well or producing formation Well drilled dry

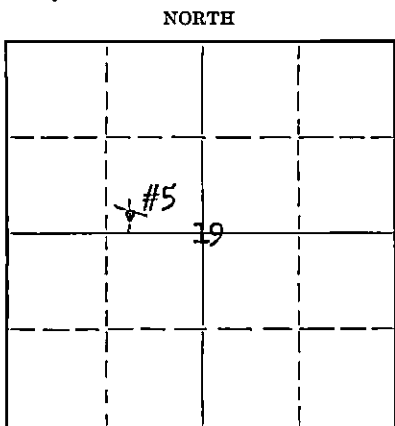

Locate well correctly on above Section Plat

If a producing well is abandoned, date of last production 19...

Was permission obtained from the Conservation Division or its agents before plugging was commenced? Yes - by telephone (Mr. Durkee)

Name of Conservation Agent who supervised plugging of this well Mr. Durkee

Producing formation None Depth to top Bottom Total Depth of Well 3635 Feet

Show depth and thickness of all water, oil and gas formations.

OIL, GAS OR WATER RECORDS

CASING RECORD

Formation	Content	From	To	Size	Put In	Pulled Out
None				9 5/8	326	None

Describe in detail the manner in which the well was plugged, indicating where the mud fluid was placed and the method or methods used in introducing it into the hole. If cement or other plugs were used, state the character of same and depth placed, from feet to feet for each plug set.

Mixed mud, circulated half way out of hole, set bridge 250' w/20 sx cmnt through drill pipe, mudded to 12' from top, filled up w/cmnt to bottom base of cellar.

(If additional description is necessary, use BACK of this sheet)

Name of Plugging Contractor Mallonee Drilling Company
Address Wichita, Kansas

STATE OF Kansas, COUNTY OF Barton, ss.
C. A. Hill, Dist. Sup't. (employee of owner) or (owner or operator) of the above-described well, being first duly sworn on oath, says: That I have knowledge of the facts, statements, and matters herein contained and the log of the above-described well as filed and that the same are true and correct. So help me God.

(Signature) *C. A. Hill*

Box 770, Great Bend, Kansas (Address)

SUBSCRIBED AND SWORN to before me this 19th day of August, 1954

My commission expires 10-15-57

RECEIVED Notary Public.
STATE CORPORATION COMMISSION

AUG 20 1954

CONSERVATION DIVISION
Wichita, Kansas

23-8390-3 6-51-20M
PLUGGING
FILE SEC 19 T 21 R 12W
BOOK PAGE 48 LINE 35


WELL LOG

E. B. HALL #5 - SW SE NW - Section 19-21S-12W - Stafford County, Kansas

Mallonee Drilling Company, Wichita, Kansas Well drilled dry & Abandoned 7/13/54

9 5/8" Csg set @ 326' w/250 sx cmnt circ. 7/2/54 - No Oil String set.

<u>Formation</u>	<u>From</u>	<u>To</u>
Sand & Clay	0	260
Red Bed	260	327
Red Bed, Shale & Shells	327	700
Anhydrite	700	735
Shale & Red Bed	735	1170
Shale & Lime	1170	1560
Lime, Sand & Shale	1560	1710
Shale & Shells	1710	1870
Lime & Shale	1870	2370
Shale & Shells	2370	2445
Shale	2445	2660
Lime & Shale	2660	3085
Lime	3085	3200
Shale	3200	3269
Lime	3269	3505
Viola Lime & Chert	3505	3530
Lime	3530	3560
Lime & Shale	3560	3598
Dolomite	3598	3605
Lime	3605	3635 TD

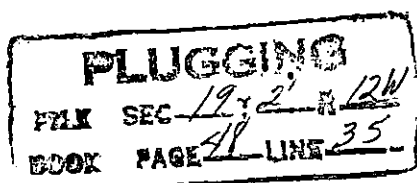

RECEIVED
 STATE CORPORATION COMMISSION

AUG 20 1954

CONSERVATION DIVISION
 WICHITA, KANSAS