

Give All Information Completely  
Make Required Affidavits  
Mail or Deliver Report to  
Conservation Division  
State Corporation Commission  
211 No. Broadway  
Wichita, Kansas

WELL PLUGGING RECORD

McPherson County, Sec 31 Twp. 21S Rge. 2 ~~XXX~~ (W)

Location as "NE/CNWxSWx" or footage from lines SE SE NW

Lease Owner Jones-Gebert Oil, Inc.

Lease Name Gehring Well No. 1

Office Address 811 Central Bldg. - Wichita 2, Kansas

Character of Well (completed as Oil, Gas or Dry Hole) Dry Hole

Date well completed February 13, 1961

Application for plugging filed February 13, 1961

Application for plugging approved February 13, 1961


Plugging commenced February 13, 1961

Plugging completed February 13, 1961

Reason for abandonment of well or producing formation Dry Hole

If a producing well is abandoned, date of last production 19

Was permission obtained from the Conservation Division or its agents before plugging was commenced? Yes

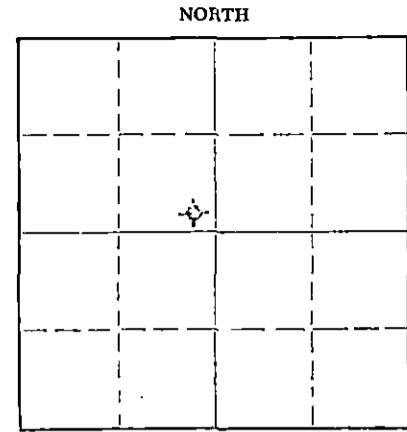

Locate well correctly on above Section Plat

Name of Conservation Agent who supervised plugging of this well Cecil M. Jones

Producing formation Depth to top Bottom Total Depth of Well 3550 Feet

Show depth and thickness of all water, oil and gas formations.

OIL, GAS OR WATER RECORDS

CASING RECORD

FORMATION	CONTENT	FROM	TO	SIZE	PUT IN	PULLED OUT
				8-5/8"	200'	

Describe in detail the manner in which the well was plugged, indicating where the mud fluid was placed and the method or methods used in introducing it into the hole. If cement or other plugs were used, state the character of same and depth placed, from feet to feet for each plug set.

Set plug at 200' w/20 sx. cement, mud to 35', set plug w/8 sx. cement.  
Rat hole 2 sx. cement

RECEIVED  
STATE CORPORATION COMMISSION

MAR 2 1961 3-2-1961

CONSERVATION DIVISION  
Wichita, Kansas

(If additional description is necessary, use BACK of this sheet)

Name of Plugging Contractor Jones-Gebert Oil, Inc.

Address 811 Central Bldg. - Wichita 2, Kansas

STATE OF Kansas, COUNTY OF Sedgwick, ss. George R. Jones

(employee of owner) or (owner or operator) of the above-described well, being first duly sworn on oath, says: That I have knowledge of the facts, statements, and matters herein contained and the log of the above-described well as filed and that the same are true and correct. So help me God.

(Signature) George R. Jones

811 Central Bldg. - Wichita 2, Kansas

(Address)

SUBSCRIBED AND SWORN TO before me this 15th day of February, 1961.

Barbara J. Layton  
Barbara J. Layton Notary Public.

My commission expires February 1, 1964



DRILLERS' LOG

Company: Jones-Gebert Oil, Inc.  
 Contractor: Jones-Gebert Oil, Inc.  
 Farm: Gehring #1  
 Location: SE SE NW Sec. 31-21S-2W  
 McPherson County, Kansas  
 Commenced: 1/31/61  
 Completed: 2/13/61

0 - 35	Water Sand
35 - 105	Sand
105 - 200	Lime broken w/shale streaks
200 - 400	Lime & shale
400 - 685	Lime & shale
685 - 895	Lime & shale streaks
895 - 1025	Lime
1025 - 1285	Lime & shale
1285 - 1540	Shale & shells
1540 - 1725	Shale & lime
1725 - 1885	Lime & shale
1885 - 2055	Lime & shale
2055 - 2165	Lime & shale w/sand streaks
2165 - 2310	Lime & shale
2310 - 2350	Lime & shale
2350 - 2415	Sandy shale
2415 - 2449	Shale & lime
2449 - 2515	Lime
2515 - 2560	Lime
2560 - 2604	Lime
2604 - 2860	Lime
2860 - 3010	Lime & shale
3010 - 3107	Shale some chert
3107 - 3190	Lime & interbedded chert
3190 - 3340	Lime & chert
3340 - 3429	Lime
3429 - 3510	Shale
3510 - 3513	Sand
3513 - 3540	Dolomite & chert
3540 - 3550	Shale
3550	Rotary Total Depth - D & A

RECEIVED  
 STATE CORPORATION COMMISSION  
 MAR 2 1961  
 CONSERVATION DIVISION  
 Wichita, Kansas

Set 8 5/8" surface casing @ 200' w/175 sacks HA5 cement.

I, George R. Jones, do hereby certify that the above and foregoing is a true and correct copy of the log of the Gehring #1, located SE SE NW of Sec. 31-21S-2W, McPherson County, Kansas, as reflected by the files of Jones-Gebert Oil, Inc.

*George R. Jones*  
 George R. Jones

STATE OF KANSAS )  
 ) SS  
 COUNTY OF SEDGWICK )

Subscribed and sworn to before me, a Notary Public, in and for Sedgwick County, Kansas, this 15th day of February, 1961.

*Barbara J. Layton*  
 Barbara J. Layton, Notary Public

My Commission Expires: February 1, 1964.