


WELL PLUGGING RECORD

Give All Information Completely
Make Required Affidavits
Mail or Deliver Report to:
Conservation Division
State Corporation Commission
211 No. Broadway
Wichita, Kansas

McPherson County, Sec. 30 Twp. 21 Rge. 2 (E) (W) X
SW SW SE

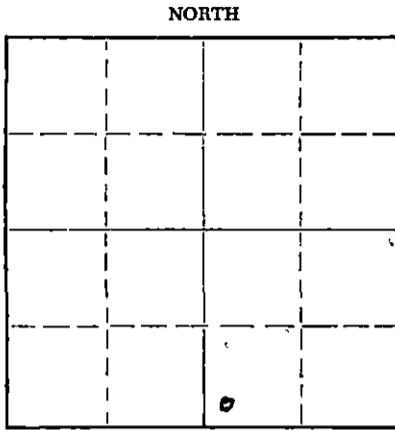

Locate well correctly on above Section Plat

Location as "NE/CNW/SW" or footage from lines
Lease Owner Roach & Lichty Drilling, Inc.
Lease Name Flickner Well No. 1
Office Address 1121 Union National Building, Wichita, Kansas
Character of Well (completed as Oil, Gas or Dry Hole) Dry Hole
Date well completed December 10, 19 56
Application for plugging filed December 10, 1956 19 56
Application for plugging approved December 10, 19 56
Plugging commenced December 10, 19 56
Plugging completed December 10, 19 56
Reason for abandonment of well or producing formation Dry

If a producing well is abandoned, date of last production _____ 19____
Was permission obtained from the Conservation Division or its agents before plugging was commenced? Yes

Name of Conservation Agent who supervised plugging of this well Ruel Durkee
Producing formation _____ Depth to top _____ Bottom _____ Total Depth of Well 3648 Feet
Show depth and thickness of all water, oil and gas formations.

OIL, GAS OR WATER RECORDS

CASING RECORD

FORMATION	CONTENT	FROM	TO	SIZE	PUT IN	PULLED OUT

Describe in detail the manner in which the well was plugged, indicating where the mud fluid was placed and the method or methods used in introducing it into the hole. If cement or other plugs were used, state the character of same and depth placed, from _____ feet to _____ feet for each plug set.

Set bridging plug at 220 and cemented with 25 sacks of cement through the drill pipe. Filled with heavy mud to 25 feet and set a bridging plug. Cemented with 5 sacks of cement on top of the plug.

(If additional description is necessary, use BACK of this sheet)

Name of Plugging Contractor Charles McKenna
Address General Delivery, Great Bend, Kansas

STATE OF Kansas, COUNTY OF Sedgwick, ss.
Clark A. Roach (employee of owner) or (owner or operator) of the above-described well, being first duly sworn on oath, says: That I have knowledge of the facts, statements, and matters herein contained and the log of the above-described well as filed and that the same are true and correct. So help me God.

(Signature) Clark A. Roach
1121 Union Nat'l. Bldg., Wichita, Kansas
(Address)

SUBSCRIBED AND SWORN TO before me this 18th day of December, 19 56

My commission expires November 8, 1960

Josephine M. Brown
Notary Public.

RECEIVED
STATE CORPORATION COMMISSION

DEC 19 1956

CONSERVATION DIVISION
Wichita, Kansas

12-19-1956

PLUGGING
FILE SEC. 30 T. 21 R. 2W
BOOK PAGE 126 LINE 10

CONTRACTOR'S WELL LOG

COMPANY: Roach & Lichty Drilling, Inc.
 CONTRACTOR: Roach & Lichty Drilling, Inc.
 FARM: Flickner No. 1
 LOCATION: SW SW SE Sec. 30-T21S-R2W
 McPherson County, Kansas
 COMMENCED: November 24, 1956
 COMPLETED: December 10, 1956

0	15	soil & clay
15	145	sand & shale
145	169	shale
169	370	shale, shell & clay
370	440	shale
440	455	Anhydrite
455	555	shale & shells
555	790	shale & lime streaks
790	845	shale, lime & salt
845	855	shale & lime
855	920	shale & lime streaks
920	1000	shale & lime
1000	1135	shale
1135	1230	limey shale
1230	1258	shale
1258	1335	limey shale
1335	1445	shale & lime
1445	1560	shale & shells
1560	2165	shale & lime
2165	2315	shale & sand streaks
2315	2755	lime & shale
2755	2844	lime
2844	3060	lime & shale
3060	3100	lime chert & shale
3100	3160	lime
3160	3203	lime, chert & shale
3203	3210	lime
3210	3245	lime, chert
3245	3408	lime
3408	3485	shale
3485	3630	shale & lime
3630	3645	sandy lime
3645	3648	shale
	3648	Rotary Total Depth

Set 8-5/8" surface at 169' with 125 sacks cement, 200# calcium chloride.

TOPS: Kansas City 2398' Kinderhook 3406' Viola 3602'
 Mississippian 3084' Hunton 3485' Simpson 3632'

STATE OF KANSAS)
) ss
 COUNTY OF SEDGWICK)

I, Clark A. Roach, do hereby certify that the above and foregoing is a true and correct copy of the log of the Flickner No. 1, SW SW SE, Sec. 30-T21S-R2W, McPherson County, Kansas, as reflected by the files of the Roach & Lichty Drlg., Inc.

ROACH & LICHTY DRILLING, INC.

BY *Clark A. Roach*
 Clark A. Roach, President

Subscribed and sworn to before me, a Notary Public, in and for Sedgwick County, Kansas, this 18th day of December, 1956.

PLUGGING
 FILE SEC 30 T 21 R 2W
 BOOK PAGE 126 L E 10

My commission expires November 8, 1960.

RECEIVED *Josephine M. Brown*
 Notary Public
 STATE CORPORATIONS COMMISSION

DEC 19 1956

CONSERVATION DIVISION
 Wichita, Kansas