


STATE OF KANSAS
STATE CORPORATION COMMISSION

Give All Information Completely
Make Required Affidavit
Mail or Deliver Report to:
Conservation Division
State Corporation Commission
211 No. Broadway
Wichita, Kansas

WELL PLUGGING RECORD

NORTH

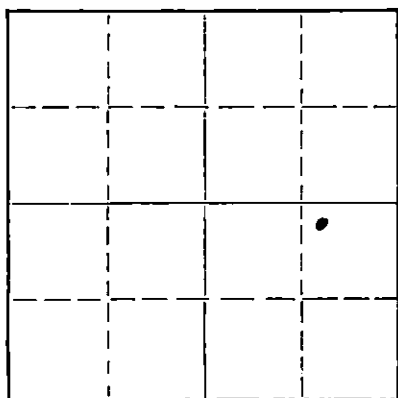

Locate well correctly on above
Section Plat

Kiowa County. Sec. 17 Twp. 28S Rge. (29) 16(W)
Location as "NE/CNW/SW" or footage from lines. NW NE SE
Lease Owner Gulf Oil Corporation
Lease Name M. E. Ross Well No. 1
Office Address Box 661, Tulsa, Oklahoma
Character of Well (completed as Oil, Gas or Dry Hole) Dry Hole
Date well completed 12-19 1957
Application for plugging filed 1-9 1958
Application for plugging approved 1-10 1958
Plugging commenced 1-13 1958
Plugging completed 1-18 1958
Reason for abandonment of well or producing formation Dry Hole

If a producing well is abandoned, date of last production - - 19 -
Was permission obtained from the Conservation Division or its agents before plugging was commenced? Yes

Name of Conservation Agent who supervised plugging of this well J. Lewis Brock
Producing formation _____ Depth to top _____ Bottom _____ Total Depth of Well 4828 Feet
Show depth and thickness of all water, oil and gas formations. 4793' PBTB

OIL, GAS OR WATER RECORDS

CASING RECORD

FORMATION	CONTENT	FROM	TO	SIZE	PUT IN	PULLED OUT
	RECEIVED STATE CORPORATION COMMISSION JAN 24 1958 CONSERVATION DIVISION Wichita, Kansas			8-5/8"	451'	0
				4-1/2"	4827'	3479'

Describe in detail the manner in which the well was plugged, indicating where the mud fluid was placed and the method or methods used in introducing it into the hole. If cement or other plugs were used, state the character of same and depth placed, from _____ feet to _____ feet for each plug set.

Filled with sand to 4700' and spotted 4 sx. cement to 4668'. Filled with mud to 350'. Set rock bridge and spotted 20 sx. cement to 290'. Filled with mud to 35'. Set rock bridge and capped with 10 sx. cement filling hole into cellar.

W. C. Bunch - Special Petty Cash Check No. 2057, dated 1-22-58, in the amount of \$48.28, is attached as payment of plugging assessment.

(If additional description is necessary, use BACK of this sheet)

Name of Plugging Contractor C. E. Shull Casing Pulling Company
Address Great Bend, Kansas

STATE OF Kansas, COUNTY OF Sedgwick, ss.
Thomas A. Trax (employee of owner) or owner or operator of the above-described well, being first duly sworn on oath, says: That I have knowledge of the facts, statements, and matters herein contained and the log of the above-described well as filed and that the same are true and correct. So help me God.

(Signature) *Thomas A. Trax*
Box 2233, Wichita, Kansas
(Address)

SUBSCRIBED AND SWORN to before me this 22nd day of January, 1958

C. C. Lewis
C. C. LEWIS, NOTARY PUBLIC Notary Public.

My commission expires 6-3-61

JRM:PF

PLUGGING
17 T 28 R 16
PAGE 75 LINE 27

WELL LOG

COMPANY **Gulf Oil Corporation**

SEC. **17** T. **28S** R. **16W**
LOC. **NW 1/4 NE 1/4 SE 1/4**

FARM **M. E. Ross**

NO. **1**

TOTAL DEPTH **4828'**

COUNTY **Kiowa**
KANSAS


COMM. **11-30-57**

COMP. **12-16-57**

SHOT OR TREATED

CONTRACTOR **Lewis Drilling Company**

ISSUED

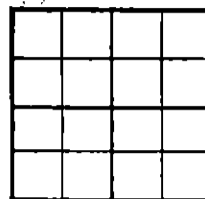

CASING

20	10
15	8 5/8" = 451'
12	6
13	5 1/2" = 4826.5'

ELEVATION **2167 K.B.**

PRODUCTION

FIGURES INDICATE BOTTOM OF FORMATIONS

0-40	Surface Clay
40-95	Shale
95-295	Sand
295-441	Blue Shale & Red bed
441-465	Anhydrite
465-850	Red bed
850-1100	Red bed & shells
1100-1750	Shale
1750-2375	Lime & shale
2375-2610	Lime
2610-2715	Lime & shale streaks
2715-3080	Lime & shale
3080-3260	Shale & lime streaks
3260-3435	Shale & lime
3435-3500	Shale & lime streaks
3500-4060	Lime & shale
4060-4170	Sandy shale & lime
4170-4335	Lime & shale
4335-4410	Lime
4410-4475	Lime & shale
4475-4555	Lime
4555-4645	Lime & shale
4645-4755	Lime
4755-4779	Cherty Lime
4779-4790	Chert
4790-4828	Cherty Lime
4828	Total Depth

Geologic Tops

Heebner	4022
Douglas	4055
Brown Lime	4181
Lans. K.C.	4202
Cherokee	4711
Mississippi Chert	4720
Kinderhook	4770
Viola	4813

RECEIVED
STATE CORPORATION COMMISSION

JAN 10 1958

REGISTRATION DIVISION

State of Kansas

State of Kansas }
County of Sedgwick } ss:

PLUGGING
FILE SEC. 17 T. 28 R. 16W
BOOK PAGE 15 LINE 24

I, William J. Duckett of the Lewis Drilling Company

upon oath state that the above and foregoing is a true and correct copy of the log of the M. E. Ross #1 well.

William J. Duckett

Subscribed and sworn to before me this 19th day of December 19 57

My Commission Expires: 8-20-60

A. R. Darrington
(A. R. Darrington) NOTARY PUBLIC