


Give All Information Completely  
Make Required Affidavit  
Mail or Deliver Report to:  
Conservation Division  
State Corporation Commission  
212 North Market, Insurance Bldg.  
Wichita, Kansas

WELL PLUGGING RECORD

NORTH

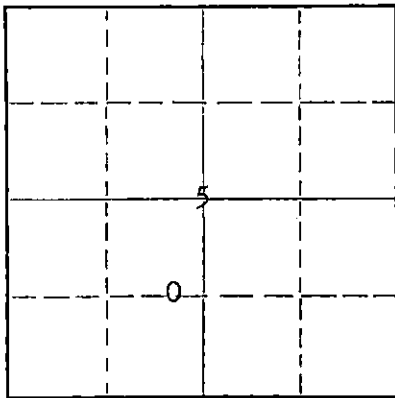

Locate well correctly on above  
Section Plat

Barton County, Sec. 5 Twp. 16S Rge. (E) 13 (W)  
Location as "NE/CNW/SW" or footage from lines E $\frac{1}{2}$  E $\frac{1}{2}$  SW $\frac{1}{4}$   
Lease Owner Shell Oil Company  
Lease Name F. H. BITTER "C" Well No. 2  
Office Address 1845 Sherman Street, Denver 3, Colorado  
Character of Well (completed as Oil, Gas or Dry Hole) Oil  
Date well completed August 21 19 60  
Application for plugging filed November 30 19 60  
Application for plugging approved (verbal) November 25 19 60  
Plugging commenced November 25 19 60  
Plugging completed December 1 19 60  
Reason for abandonment of well or producing formation Oil Depleted

If a producing well is abandoned, date of last production September 1 19 60  
Was permission obtained from the Conservation Division or its agents before plugging was commenced? Yes

Name of Conservation Agent who supervised plugging of this well Donald Truan  
Producing formation Arbuckle Depth to top 3349 Bottom - Total Depth of Well 3356 Feet  
Show depth and thickness of all water, oil and gas formations.

OIL, GAS OR WATER RECORDS

CASING RECORD

FORMATION	CONTENT	FROM	TO	SIZE	PUT IN	PULLED OUT
Arbuckle	I.P. 9111 BO, no water, 24 hours.	3350	3356	8 5/8" 4 1/2"	643' 3350'	None 2209'

Describe in detail the manner in which the well was plugged, indicating where the mud fluid was placed and the method or methods used in introducing it into the hole. If cement or other plugs were used, state the character of same and depth placed, from \_\_\_\_\_ feet to \_\_\_\_\_ feet for each plug set.

Filled hole with sand to 3336 & dumped 5 sax cement to 3276. Mudded hole to 350, set rock bridge to 340 & dumped 25 sax cement to 265. Mudded hole to 40, set rock bridge to 30 & dumped 10 sax cement, cementing to base of cellar.

3356-3336 PB w/ sand  
3336-3276 PB w/ cement  
3276-350 PB w/ mud  
350-340 PB w/ rock  
340-265 PB w/ cement  
265-40 PB w/ mud  
40-30 PB w/ rock  
30-0 PB w/ cement

RECEIVED  
STATE CORPORATION COMMISSION  
FEB 3 1961  
CONSERVATION DIVISION  
Wichita, Kansas

(If additional description is necessary, use BACK of this sheet)

Name of Plugging Contractor Forbes Casing Pulling Company  
Address P. O. Box 221, Great Bend, Kansas

STATE OF COLORADO, COUNTY OF DENVER, ss.  
J. E. Tuttle (employee of owner) of the above-described well, being first duly sworn on oath, says: That I have knowledge of the facts, statements, and matters herein contained and the log of the above-described well as filed and that the same are true and correct. So help me God.

(Signature) J. E. Tuttle  
J. E. Tuttle  
1845 Sherman Street, Denver 3, Colorado  
(Address)

SUBSCRIBED AND SWORN TO before me this 6th day of February, 19 61

My commission expires September 15, 1962

Donna M. Trueman  
Notary Public.

15-009-03414-00-00

Shell-F. H. Bitter "C" #2  
E/2 E/2 SW/4 Section 5-16S-13W  
Trapp Field  
Barton County, Kansas

Casing Record

8 5/8" cem 643 with 160 sax  
4 1/2" cem 3350 with 100 sax

- 0 - 35 surface clay
- 50 shale
- 120 sand & shale
- 200 shale & lime streaks
- 365 lime & shale
- 385 pyrite
- 390 lime
- 455 shale & shells
- 484 lime & pyrite
- 522 shale & shells
- 525 pyrite
- 585 lime shells & shale
- 643 red bed
- 593 red rock & shale
- 865 red bed
- 907 anhydrite
- 965 shale
- 1310 shale & shells
- 1530 salt & shale
- 1578 anhydrite & shale
- 1666 shale, anhydrite & chert streaks
- 1707 shale & anhydrite
- 1820 chert, shale & lime
- 1907 lime & shale
- 1938 lime
- 1950 chert
- 1995 shale
- 2010 chert
- 2025 lime
- 2060 lime & chert
- 2325 lime & shale
- 2405 shale & lime streaks
- 2514 shale & lime
- 2582 shale & lime streaks
- 2665 shale & lime
- 2750 shale
- 2800 shale & lime
- 2995 lime Top Topeka 2799
- 3026 lime & shale
- 3062 lime
- 3086 shale
- 3128 lime Top Lansing-Kansas City 3102
- 3205 lime & shale
- 3248 lime
- 3282 lime & chert
- 3349 lime Top Arbuckle 3349 SLC
- 3356 dolomite T.D.

INDEXED  
SERIALIZED

FILED  
CONSERVATION DIVISION  
Wichita, Kansas