

STATE OF KANSAS
STATE CORPORATION COMMISSION

WELL PLUGGING RECORD

Give All Information Completely
Make Required Affidavit
Mail or Deliver Report to:
Conservation Division
State Corporation Commission
800 Biting Building
Wichita, Kansas

Stafford County, Sec. 6 Twp. 21S Rge. 11 (W)

Location as "NE/CNW/SW" or footage from lines SE SE SE

Lease Owner Veeder Supply & Development co. et al

Lease Name Diets Well No. 4

Office Address P. O. Box 201, Cherryvale, Kansas

Character of Well (completed as Oil, Gas or Dry Hole)

Date well completed January 13 19 55

Application for plugging filed January 13 19 55

Application for plugging approved January 13 19 55


Plugging commenced January 13 19 55

Plugging completed January 13 19 55

Reason for abandonment of well or producing formation on account of losing bit, drill collar and drill pipe in hole.

If a producing well is abandoned, date of last production 19

Was permission obtained from the Conservation Division or its agents before plugging was commenced? Yes

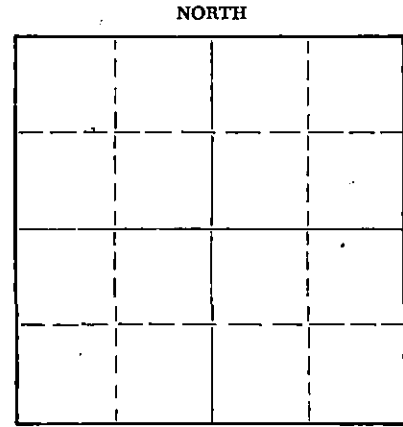

Locate well correctly on above Section Plat

Name of Conservation Agent who supervised plugging of this well M. R. Rivers

Producing formation _____ Depth to top _____ Bottom _____ Total Depth of Well 2510 Feet

Show depth and thickness of all water, oil and gas formations.

OIL, GAS OR WATER RECORDS

CASING RECORD

FORMATION	CONTENT	FROM	TO	SIZE	PUT IN	PULLED OUT
				8 5/8"	235'	
					w/170 sacks cement	

Describe in detail the manner in which the well was plugged, indicating where the mud fluid was placed and the method or methods used in introducing it into the hole. If cement or other plugs were used, state the character of same and depth placed, from _____ feet to _____ feet for each plug set.

set plug, 1/2 sack hulls

Plugged with heavy mud to 220' and 20 sacks cement; heavy mud to 35', set second plug and 1/2 sack hulls and 10 sacks cement to surface.

(If additional description is necessary, use BACK of this sheet)

Name of Plugging Contractor Veeder Supply and Development Co.

Address P. O. Box 201, Cherryvale, Kansas

STATE OF Kansas COUNTY OF Montgomery, ss.

Floyd W. Hild (employee of owner) or owner or operator of the above-described

well, being first duly sworn on oath, says: That I have knowledge of the facts, statements, and matters herein contained and the log of the above-described well as filed and that the same are true and correct. So help me God.


(Signature) Floyd W. Hild

Cherryvale, Kansas (Address)

SUBSCRIBED AND SWORN to before me this 17th day of January 19 55

Notary Public. (Signature)

My commission expires July 11, 1956

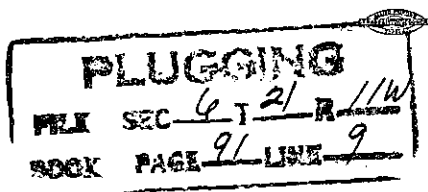

1-18-55

Veeder Supply & Dev'l. Co.

Cherryvale, Kansas

Louis Kahan

Drilled for Producers Pipe & Supply, V. S. Co. Farm Diets No. 4 Depth 2510

Contractor Veeder Supply & Development Co. Pipe 235' 8 5/8" csg. cemented w/170 sacks cement

Location SE SE SE Sec. 6 Twp. 21S Range 11W

Commenced 1-4-1955 Completed 1-13-1955 County Stafford State Kansas

Sand and clay	0	35	35
Clay and shells	35	235	200
Red bed and shale	235	1000	765
Shale and lime shells	1000	1550	550
Lime and shale	1550	1795	245
Lime	1795	1915	120
Lime and shale	1915	1950	35
Shale and lime shells	1950	2320	370
Lime and shale	2320	2510	190
Total depth	2510		

Well abandoned and plugged

AFFIDAVITSTATE OF KANSAS)
Montgomery County) SS

Floyd W. Hild, of lawful age, being first duly sworn on oath, deposes and says:

That he is a resident of Cherryvale, Montgomery County, Kansas; that he knows and hereby on oath states that the above and foregoing drilling log covering the Diets #4 well located in Section 6-21S-11W, Stafford County, Kansas, is true and correct. Further affiant saith not.

THE VEEDER SUPPLY AND DEVELOPMENT CO.

BY Floyd W. Hild
Floyd W. Hild

Subscribed and sworn to before me this 17th day of January, 1955.

Charles Larsson
Notary Public

My commission expires July 11, 1956.

