


STATE OF KANSAS  
STATE CORPORATION COMMISSION

Give All Information Completely  
Make Required Affidavit  
Mail or Deliver Report to:  
Conservation Division  
State Corporation Commission  
211 No. Broadway  
Wichita, Kansas

WELL PLUGGING RECORD

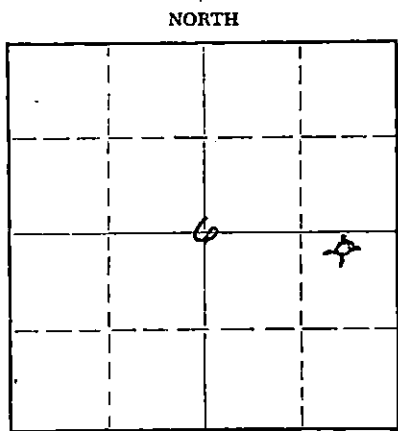

Locate well correctly on above  
Section Plat

Stafford County. Sec. 6 Twp. 21 Rge.      (E) 11 (W)  
Location as "NE/CNW/SW" or footage from lines N/2 NE SE  
Lease Owner Veeder Supply & Development  
Lease Name Diets Well No. 8  
Office Address Box 201, Cherryvale, Kansas  
Character of Well (completed as Oil, Gas or Dry Hole) dry hole  
Date well completed 8-19-65 19       
Application for plugging filed 8-23 19 65  
Application for plugging approved 19       
Plugging commenced 3:00 p.m., August 19, 1965 19       
Plugging completed 5:00 p.m., August 19, 1965 19       
Reason for abandonment of well or producing formation dry hole

If a producing well is abandoned, date of last production 19       
Was permission obtained from the Conservation Division or its agents before plugging was commenced? yes

Name of Conservation Agent who supervised plugging of this well Archie Elwing  
Producing formation      Depth to top      Bottom      Total Depth of Well      Feet  
Show depth and thickness of all water, oil and gas formations.

OIL, GAS OR WATER RECORDS

CASING RECORD

FORMATION	CONTENT	FROM	TO	SIZE	PUT IN	PULLED OUT
		0'	320'	8 5/8"	320'	none

Describe in detail the manner in which the well was plugged, indicating where the mud fluid was placed and the method or methods used in introducing it into the hole. If cement or other plugs were used, state the character of same and depth placed, from      feet to      feet for each plug set.

Bottom plug @ 315' with 1/4 sack hulls and 25 sx cement thru drill pipe.  
Top plug @ 40' with 1/2 sack hulls and 10 sx cement.  
two sx cement in rat hole.

RECEIVED  
STATE CORPORATION COMMISSION  
AUG 24 1965  
8-24-65  
CONSERVATION DIVISION  
Wichita, Kansas

(If additional description is necessary, use BACK of this sheet)  
Name of Plugging Contractor Vaughan Drilling, Inc.  
Address Box 825, Great Bend, Kansas

STATE OF KANSAS, COUNTY OF BARTON, ss.  
DONALD D. VAUGHAN (employee of owner) or (owner or operator) of the above-described well, being first duly sworn on oath, says: That I have knowledge of the facts, statements, and matters herein contained and the log of the above-described well as filed and that the same are true and correct. So help me God.

(Signature) Donald D. Vaughan  
VAUGHAN DRILLING, INC., by: Donald D. Vaughan, Pres.  
Box 825, Great Bend, Kansas  
(Address)

SUBSCRIBED AND SWORN TO before me this 23rd day of August, 19 65

My commission expires Jan. 24, 1968  
Dorothy Tully Notary Public.

## WELL LOG

COMPANY	Veeder Supply & Development Co.
CONTRACTOR	Vaughan Drilling, Inc.
FARM	#8 Diets.
LOCATION	N/2 NE SE of sec. 6-21-11W Stafford County, Kansas
ELEVATION	1817 K. B.
SURFACE PIPE	8 5/8" set @ 320' with 235 sx posmix sunset.
PRODUCTION	D-& A.
COMMENCED	8-9-65
COMPLETED	8-19-65

<u>FORMATION</u>	<u>DEPTH</u>
Sandstone & Clay	175
Shale & Sand streaks	225
Red Bed	549
Anhydrite	580
Shale & Shells	1350
Limestone & Shale	2900
Limestone	3022
Shale & Sandstone	3055
Shale & Limestone	3180
Limestone	3421
Arbuckle	3500
Rotary Total Depth	3500

FORMATION TOPS

Anhydrite	549 (+1268)
Topeka	2750 (- 933)
Heepner	3004 (-1187)
Toronto	3027 (-1210)
Douglas	3037 (-1220)
Brown Limestone	3128 (-1311)
Lansing	3145 (-1328)
Base Kansas City	3375 (-1558)
Arbuckle	3421 (-1604)
Rotary Total Depth	3500 (-1683)

RECEIVED  
STATE CORPORATION COMMISSION

AUG 24 1965

CONSERVATION DIVISION  
Wichita, Kansas

A F F I D A V I T


STATE OF KANSAS., COUNTY OF BARTON, SS:

I, Donald D. Vaughan, of the VAUGHAN DRILLING, INC., being first duly sworn on oath, state; that I have knowledge of the facts, statements and matters herein contained and that the same are true and correct.

  
Donald D. Vaughan, Pres.

Subscribed and sworn to before me this 23rd day of August, 1965.

My commission expires: Jan. 24, 1968

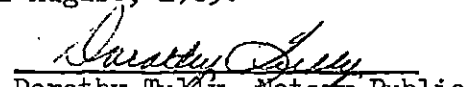  
Dorothy Tukey, Notary Public