


STATE OF KANSAS
STATE CORPORATION COMMISSION
Give All Information Completely
Make Required Affidavit
Mail or Deliver Report to:
Conservation Division
State Corporation Commission
800 Bittling Building
Wichita, Kansas

WELL PLUGGING RECORD

NORTH

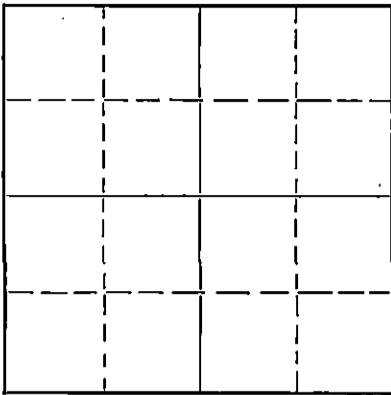

Locate well correctly on above
Section Flat

Stafford County. Sec. 6 Twp. 21S Rge. 11W(±) 11 (W)
Location as "NE/CNW¼SW¼" or footage from lines NW NE SW
Lease Owner J. M. Huber Corp.
Lease Name Sparks Well No. I
Office Address Wichita Kansas
Character of Well (completed as Oil, Gas or Dry Hole) Dry Hole
Date well completed 7-22-50 19
Application for plugging filed 7-22-50 19
Application for plugging approved 7-22-50 19
Plugging commenced 7-22-50 19
Plugging completed 7-22-50 19
Reason for abandonment of well or producing formation

If a producing well is abandoned, date of last production 19
Was permission obtained from the Conservation Division or its agents before plugging was commenced? yes

Name of Conservation Agent who supervised plugging of this well Roul Durkee
Producing formation Depth to top Bottom Total Depth of Well 356.7 Feet
Show depth and thickness of all water, oil and gas formations.

OIL, GAS OR WATER RECORDS

CASING RECORD

Formation	Content	From	To	Size	Put In	Pulled Out

Describe in detail the manner in which the well was plugged, indicating where the mud fluid was placed and the method or methods used in introducing it into the hole. If cement or other plugs were used, state the character of same and depth placed, from feet to feet for each plug set.

Set plug No. 1 at 275' and cemented with 15 sx cement. Set plug No. 2 at 25' and cemented with 10 sx cement.

RECEIVED
JUL 26 1950
CONSERVATION
DIVISION
KANSAS
7126150

(If additional description is necessary, use BACK of this sheet)

Correspondence regarding this well should be addressed to J. M. Huber Corporation
Address Petroleum Building
Wichita Kansas

STATE OF Kansas, COUNTY OF Sedgwick, ss.
D. J. Briggs (employee of owner) or (owner or operator) of the above-described well,
being first duly sworn on oath, says: That I have knowledge of the facts, statements, and matters herein contained and the log of the above-described well as filed and that the same are true and correct. So help me God.

(Signature) D. J. Briggs
D. J. Briggs
Wichita Kansas
(Address)

SUBSCRIBED AND SWORN to before me this 24 day of July 19 50

Ruth M. Sander
Notary Public.

My commission expires March 2, 1953

PLUGGING
FILE SEC 6 T 21 R 11W
BOOK PAGE 18 LINE 1

DRILLERS LOG

COMPANY: J. M. Huber Corporation
CONTRACTOR: Pabco Drilling, Inc.

LOCATION: NW NE SW
6-21S-11W
Stafford Co
Kansas

FARM NAME: No. 1 Sparks

COMMENCED: 7-9-50
COMPLETED: 7-22-50

PRODUCTION: D & A

CASING USED:
8 5/8" 277' cem w 175 sx

Sand	40
Sand & Shale	80
Red Bed & Shale	277
Sandy Red Bed	540
Shale & Red Bed	580
Anhydrite	610
Shale & Shells	1250
Shale & Salt	1375
Shale & Lime	1565
Sandy Lime & Shale	1735
Lime & Shale	1875
Shale	1995
Lime & Shale	2200
Shale	2544
Lime & Shale	2675
Lime	2859
Lime & Shale	2953
Lime	3000
Lime & Shale	3171
Lime	3181
Lime & Shale	3407
Lime Conglomerate	3420
Cherty Conglomerate	3450
Lime	3480
Cherty Conglomerate	3529
Simpson Shale	3558
Lime	3567
Total Depth	3567

RECEIVED
Conservation Div.
JUL 26 1950
STATE CORPORATION
COMMISSION
KANSAS

STATE OF KANSAS)
) SS:
COUNTY OF SEDGWICK)

I, D. J. Briggs, do hereby certify that the above is a true and correct copy of the log on the above captioned well, as shown on the daily drilling report.

PABCO DRILLING, INC.

D. J. Briggs
D. J. Briggs

Subscribed and sworn to before me this 24th day of July, 1950.

Russ M. Gardner
Notary Public

My commission expires March 2, 1953.

PLUGGING
FILE SEC-6-T21-R114
BOOK PAGE 18 LINE 1