


STATE OF KANSAS  
STATE CORPORATION COMMISSION

WELL PLUGGING RECORD

Give All Information Completely  
Make Required Affidavit  
Mail or Deliver Report to:  
Conservation Division  
State Corporation Commission  
211 No. Broadway  
Wichita, Kansas

Stafford County, Sec. 7 Twp. 21 Rge. 11 (E) W (W)  
Location as "NE/CNW/SW" or footage from lines NW NE NE  
Lease Owner ~~XXXXXXXXXXXX~~ Fred D. Asbury  
Lease Name Schlochtermeyer Well No. 7  
Office Address 161 West 4th, Hoisington, Ks.  
Character of Well (completed as Oil, Gas or Dry Hole) Dry Hole  
Date well completed 10-5 19 62  
Application for plugging filed 10-5 19 62  
Application for plugging approved " 19 62  
Plugging commenced 10-5 19 62  
Plugging completed 10-6 19 62  
Reason for abandonment of well or producing formation Dry Hole

NORTH

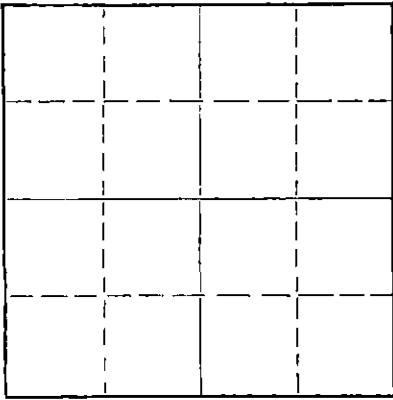

Locate well correctly on above  
Section Plat

If a producing well is abandoned, date of last production 19  
Was permission obtained from the Conservation Division or its agents before plugging was commenced? yes

Name of Conservation Agent who supervised plugging of this well Mr. Laekamp  
Producing formation \_\_\_\_\_ Depth to top \_\_\_\_\_ Bottom \_\_\_\_\_ Total Depth of Well 3456 Feet  
Show depth and thickness of all water, oil and gas formations.

OIL, GAS OR WATER RECORDS

CASING RECORD

FORMATION	CONTENT	FROM	TO	SIZE	PUT IN	PULLED OUT

Describe in detail the manner in which the well was plugged, indicating where the mud fluid was placed and the method or methods used in introducing it into the hole. If cement or other plugs were used, state the character of same and depth placed, from \_\_\_\_\_ feet to \_\_\_\_\_ feet for each plug set.

Filled hole with heavy mud to 240' - set wooden plug  
1/3 sack hulls and 20 sacks cement through D.P.  
Filled hole to 35'-set wooden plug - 1/3 sack hulls - 10 sacks  
cement.  
Plugged rat hole

RECEIVED  
STATE CORPORATION COMMISSION

OCT 11 1962 10-11-62

CONSERVATION DIVISION  
Wichita, Kansas

(If additional description is necessary, use BACK of this sheet)

Name of Plugging Contractor Duke Drilling Co.  
Address Box 823, Great Bend, Ks.

STATE OF KANSAS, COUNTY OF BARTON, ss.  
L. O. Chubb (employee of owner) or (owner) of the above-described well, being first duly sworn on oath, says: That I have knowledge of the facts, statements, and matters herein contained and the log of the above-described well as filed and that the same are true and correct. So help me God.

(Signature) L. O. Chubb  
Box 823, Great Bend, Ks.  
(Address)

SUBSCRIBED AND SWORN TO before me this 10th day of October, 19 62

My commission expires June 24, 1963

Clair E. Stimson  
Clair E. Stimson Notary Public.



15.185.12150.0000

W E L L L O G

Date Commenced: September 28, 1962  
Date Completed: October 6, 1962

F.D. Asbury  
SCHLOCHTERMEIER #7  
NW NE NE Sec. 7-21-11w  
Stafford County, Ks.

0	-	60	Clay - Sand
60	-	165	Sand
165	-	567	Red Bed
567	-	589	ANHYDRITE
589	-	815	Red Bed
815	-	1440	Shale - Shells
1440	-	2010	Shale & Lime
2010	-	2825	Lime & Shale
2825	-	3004	Lime
3004	-	3009	Shale HEEBNER
3009	-	3023	Lime & Shale
3023	-	3038	Lime TORONTO
3038	-	3126	Shale DOUGLAS
3126	-	3146	Lime Shale BROWN LIME
3146	-	3400	Lime LANSING
3400	-	3456	CONGLOMERATE Shale & Sand

ELEVATION: 1808 K.B.

FORMATION DATA:


Heebner	3004
Brown Lime	3126
Lansing	3146
Conglomerate	3400
R.T.D.	3456

SURFACE CASING: Set 290'  
of 8-5/8" casing @ 286'  
with 200 sacks cement.

A F F I D A V I T

STATE OF KANSAS  
COUNTY OF BARTON )ss

Lewis O. Chubb, of lawful age, does swear that the facts and statements herein contained are true and correct to the best of his knowledge.

  
Lewis O. Chubb

Subscribed and sworn to before me this 10th day of October - 1962.

  
Clair E. Stimson  
NOTARY PUBLIC

My Comm. Expires: June 24, 1963.

**RECEIVED**  
STATE CORPORATION COMMISSION  
OCT 11 1962  
CONSERVATION DIVISION  
Wichita, Kansas