

STATE OF KANSAS
STATE CORPORATION COMMISSION

WELL PLUGGING RECORD

Give All Information Completely
Make Required Affidavit
Mail or Deliver Report to:
Conservation Division
State Corporation Commission
211 No. Broadway
Wichita, Kansas

Stafford County. Sec. 7 Twp. 21 Rge. 11 (E) W (W)

Location as "NE/CNW/SW" or footage from lines 150' W SE SE NE

Lease Owner F. D. Asbury

Lease Name Schlochtermeyer Well No. 5

Office Address 161 West 4th Street, Hoisington, Kansas

Character of Well (completed as Oil, Gas or Dry Hole) Dry Hole

Date well completed March 30, 19 60

Application for plugging filed March 30, 19 60

Application for plugging approved 19


Plugging commenced March 30, 19 60

Plugging completed March 30, 19 60

Reason for abandonment of well or producing formation Dry

If a producing well is abandoned, date of last production _____ 19 _____

Was permission obtained from the Conservation Division or its agents before plugging was commenced? Yes

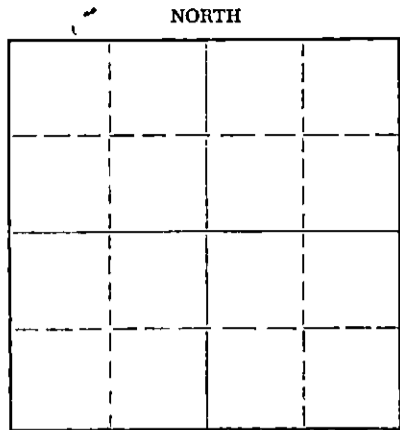

Locate well correctly on above Section Plat

Name of Conservation Agent who supervised plugging of this well Mr. Broadfoot

Producing formation _____ Depth to top _____ Bottom _____ Total Depth of Well 3469 Feet

Show depth and thickness of all water, oil and gas formations.

OIL, GAS OR WATER RECORDS

CASING RECORD

FORMATION	CONTENT	FROM	TO	SIZE	PUT IN	PULLED OUT

Describe in detail the manner in which the well was plugged, indicating where the mud fluid was placed and the method or methods used in introducing it into the hole. If cement or other plugs were used, state the character of same and depth placed, from _____ feet to _____ feet for each plug set.

Filled hole with heavy mud to 240'. Plug 1/4 sack Hulls and 20 sacks wet cement through drill pipe. Fill to 35' with heavy mud. Plug 1/4 sack Hulls 10 sacks wet cement.

STATE CORPORATION COMMISSION
APR 1 1960
CONSERVATION DIVISION
Wichita, Kansas

(If additional description is necessary, use BACK of this sheet)

Name of Plugging Contractor _____
Address _____

STATE OF Kansas COUNTY OF Barton, ss.
Cecil M. Olson (employee of owner) or (owner or operator) of the above-described

well, being first duly sworn on oath, says: That I have knowledge of the facts, statements, and matters herein contained and the log of the above-described well as filed and that the same are true and correct. So help me God.

(Signature) Cecil M. Olson

Box 123, Great Bend, Kansas
(Address)

SUBSCRIBED AND SWORN TO before me this 31st day of March, 19 60

My commission expires June 24, 1963.

Clair E. Stimson
Clair E. Stimson Notary Public.



WELL LOG

Date Commenced March 16, 1960
 Date Completed March 30, 1960

F. D. Asbury
 Schlochtermeyer #5
 150' West of SE SE NE
 Section 7-21S-11W
 Stafford County, Kansas

0' - 30'	Surface Sand
30' - 37'	Shale
37' - 195'	Sand
195' - 260'	Red Beds
260' - 574'	Red Beds
574' - 597'	ANHYDRITE
597' - 745'	Shale & Shells
745' - 1150'	Shale & Shells
1150' - 1300'	Salt & Shale
1300' - 1525'	Shale & Lime
1525' - 1725'	Lime & Shale
1725' - 1970'	Shale & Lime
1970' - 2350'	Lime & Shale
2350' - 2595'	Lime & Shale
2595' - 2690'	Lime & Shale
2690' - 2835'	Lime
2835' - 3011'	Lime
3011' - 3016'	Shale HEEBNER
3016' - 3022'	Lime
3022' - 3035'	Shale
3035' - 3046'	Lime TORONTO
3046' - 3137'	Shale DOUGLAS
3137' - 3142'	Lime IATAN
3142' - 3154'	Shale
3154' - 3410'	Lime & Shale LANSING
3410' - 3421'	CONGLOMERATE
3421' - 3462'	Shale SIMPSON
3462' - 3469'	Dolomite ARBUCKLE

Elevation 1814 KB

Anhydrite base	597	/1257
Heebner	3011	-1197
Toronto	3035	-1221
Douglas	3046	-1232
Iatan	3137	-1323
Lansing	3154	-1340
Conglomerate	3410	-1596
Simpson	3421	-1607
Arbuckle	3462	-1648
RTD	3469	-1655

Casing: Set 286' of 8 5/8" good used smls pipe with 200 sacks cement.

RECEIVED
 STATE CORPORATION COMMISSION
 APR 1 1960
 CONSERVATION DIVISION
 Wichita, Kansas

AFFIDAVIT

State of Kansas County of Barton

I, Lewis O. Chubb, Geologist, do swear that the statements and matters herein contained are true to the best of my knowledge.

THE DUKE DRILLING COMPANY

By: Lewis O. Chubb
 Geologist

Subscribed and sworn to before me this 31st day of March, 1960

Clair E. Steiner
 Notary Public

My Commission Expires: June 24, 1963.