


STATE OF KANSAS
STATE CORPORATION COMMISSION

WELL PLUGGING RECORD

Give All Information Completely
Make Required Affidavit
Mail or Deliver Report to:
Conservation Division
State Corporation Commission
211 No. Broadway
Wichita, Kansas

Stafford County. Sec. 7 Twp. 21 Rge. 11 (E) W(W)

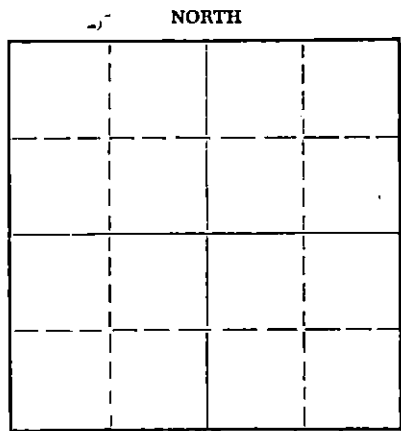

Location as "NE/CNWKSWK" or footage from lines NW NE NW
Lease Owner F. G. Holl
Lease Name Schlochtermeyer Well No. 1
Office Address 6427 E. Kellogg Wichita, Kansas
Character of Well (completed as Oil, Gas or Dry Hole) Dry Hole
Date well completed Aug. 24 19 61
Application for plugging filed Aug. 24 19 61
Application for plugging approved 19
Plugging commenced Aug. 24 19 61
Plugging completed Aug. 24 19 61
Reason for abandonment of well or producing formation Dry
If a producing well is abandoned, date of last production 19
Was permission obtained from the Conservation Division or its agents before plugging was commenced? ~~Yes~~ Yes

Name of Conservation Agent who supervised plugging of this well Mr. Frank Broadfoot
Producing formation Depth to top Bottom Total Depth of Well Feet
Show depth and thickness of all water, oil and gas formations.

OIL, GAS OR WATER RECORDS

CASING RECORD

FORMATION	CONTENT	FROM	TO	SIZE	PUT IN	PULLED OUT

Describe in detail the manner in which the well was plugged, indicating where the mud fluid was placed and the method or methods used in introducing it into the hole. If cement or other plugs were used, state the character of same and depth placed, from feet to feet for each plug set.

Filled hole with heavy mud to 240'.
Placed wooden plug 1/2 sack hulls and 20 sacks cement at 240' down drill pipe.
Filled hole to 35' placed wooden plug and 1/2 sack hulls and 10 sacks cement.

RECEIVED
STATE CORPORATION COMMISSION

AUG 30 1961

CONSERVATION DIVISION
Wichita, Kansas

8-30-61

(If additional description is necessary, use BACK of this sheet)

Name of Plugging Contractor The Duke Drilling Company
Address Box 823, Great Bend, Kansas

STATE OF KANSAS, COUNTY OF Barton, ss.
L. O. Chubb (employee of owner) or (owner or operator) of the above-described well, being first duly sworn on oath, says: That I have knowledge of the facts, statements, and matters herein contained and the log of the above-described well as filed and that the same are true and correct. So help me God.

(Signature) L. O. Chubb
Box 823, Great Bend, Kansas (Address)

SUBSCRIBED AND SWORN TO before me this 25th day of August, 19 61

My commission expires April 11, 1963 John Poos Notary Public.

W E L L L O G

Date Commenced: August 17, 1961
 Date Completed: August 24, 1961

F. G. Holl
 SCHLOCHTERMEIER # 1
 NW NE NW Sec. 7-21-11w
 Stafford County, Kansas

0' - 45' Sand
 45' - 150' Clay and Sand
 150' - 230' Clay
 230' - 589' Red Bed
 589' - 608' ANHYDRITE
 608' - 1420' Shale - Shells
 1420' - 1515' Lime & Shale
 1515' - 1940' Shale & Lime
 1940' - 2880' Lime - Shale
 2880' - 3028' Lime
 3028' - 3047' Shale & Lime HEEBNER
 3047' - 3060' Lime TORONTO
 3060' - 3151' Shale DOUGLAS
 3151' - 3170' Lime - Shale BROWN LIME
 3170' - 3417' Lime LANSING
 3417' - 3427' CONGLOMERATE Shale
 3427' - 3521 CONGLOMERATE Cherty

FORMATIONS:
 ANHYDRITE 589 1231
 HEEBNER 3028 -1208
 TORONTO 3047 -1227
 DOUGLAS 3060 -1240
 BROWN LIME 3151 -1331
 LANSING 3170 -1350
 CONGLOMERATE 3417 -1597
 R.T.D. 3521 -1701

SURFACE CASING:
 Set 273' of 8-5/8" casing with 225
 sacks cement at 272' by The
 Halliburton Company

RECEIVED
 STATE CORPORATION COMMISSION

AUG 30 1961

CONSERVATION DIVISION
 Wichita, Kansas

A F F I D A V I T

STATE OF KANSAS)
 COUNTY OF BARTON) ss.

I, Lewis O. Chubb, of lawful age, being first duly sworn on oath,
 depose and state that I am Geologist for The Duke Drilling Company,
 and that the facts and statements herein contained are true and correct
 to the best of my knowledge.

Lewis O. Chubb
 Lewis O. Chubb

Subscribed and sworn to before me this 29th day of August, 1961

John W. Pocs
 John W. Pocs Notary Public

My Commission Expires: April 11, 1963