

STATE OF KANSAS
STATE CORPORATION COMMISSION

WELL PLUGGING RECORD

OR

FORMATION PLUGGING RECORD


Strike out upper line
when reporting plug-
ging of formations.

Give All Information Completely
Make Required Affidavit
Mail or Deliver Report to:
Conservation Division
State Corporation Commission
800 Bittling Building
Wichita, Kansas

Stafford County. Sec. 7 Twp. 21S Rge. 11 (E) (W)

Location as "NE $\frac{1}{4}$ NW $\frac{1}{4}$ SW $\frac{1}{4}$ " or footage from lines SE $\frac{1}{4}$ SE $\frac{1}{4}$ NW $\frac{1}{4}$
Lease Owner Virginia Drilling Company, Inc.
Lease Name Schlochtermeyer Well No. 1
Office Address 314 Butts Bldg., Wichita, Kansas
Character of Well (Completed as Oil, Gas or Dry Hole) Dry Hole
Date, well completed March 22, 193 9
Application for plugging filed April 1, 193 9
Application for plugging approved April 10, 193 9
Plugging Commenced April 10, 193 9
Plugging Completed April 25, 193 9
Reason for abandonment of well or producing formation dry hole

NORTH

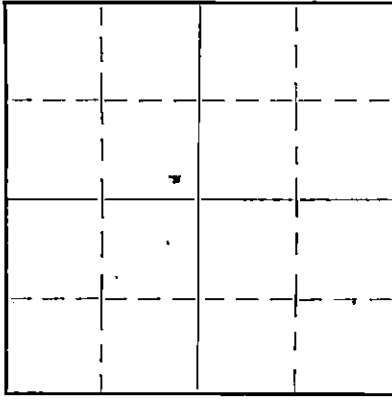

Locate well correctly on above
Section Plat

If a producing well is abandoned, date of last production 193
Was permission obtained from the Conservation Division or its agents before plugging was com-
menced? yes

Name of Conservation Agent who supervised plugging of this well Guy Wiershing
Producing formation Depth to top Bottom Total Depth of Well 3580 Feet.

Show depth and thickness of all water, oil and gas formations.

OIL, GAS OR WATER RECORDS

CASING RECORD

| Formation | Content | From | To | Size | Put In | Pulled Out |
|-----------|---------|------|----|---------|--------|------------|
| | | | | 7" O.D. | 3456 | 1656 |
| | | | | 10" | 247 | -- |
| | | | | | | |
| | | | | | | |
| | | | | | | |
| | | | | | | |
| | | | | | | |
| | | | | | | |
| | | | | | | |

Describe in detail the manner in which the well was plugged, indicating where the mud fluid was placed and the method or methods used in introducing it into the hole. If cement or other plugs were used, state the character of same and depth placed, from feet to feet for each plug set.

Hole filled with mud. Set 5 foot plug at 265 feet. Filled to within 15 feet of top. Wood plug set and filled to top with cement.

PLUGGING
FILE SEC 2 T 21 R 11 W
BOOK PAGE 57 LINE 31



4-27-39

(If additional description is necessary, use BACK of this sheet)

Correspondence regarding this well should be addressed to Virginia Drilling Company, Inc.
Address 314 Butts Bldg., Wichita, Kansas

STATE OF Kansas COUNTY OF Sedgwick, ss.
D. J. Murphy (employee of owner) or (owner or operator) of the above-described well,

being first duly sworn on oath, says: That I have knowledge of the facts, statements, and matters herein contained and the log of the above-described well as filed and that the same are true and correct. So help me God

(Signature) D. J. Murphy

Ellinwood, Kansas (Address)

SUBSCRIBED AND SWORN to before me this 25th day of April 1939

My commission expires February 5, 1941

Notary Public

Schlöchtermeyer #1 - SE 1/4 of Section 7-21S-11W Stafford County, Kansas
 Company - Virginia Drilling Company, Inc.
 Contractor - Virginia Drilling Company, Inc.
 Commenced - November 14, 1938
 Completed - March 22, 1939
 Total Depth - 3580'
 Elevation - 1813
 Dry Hole

15.185.01878.0000

| FORMATION | DEPTH |
|--------------------------|-----------|
| Sand, Gravel, Shale | 0- 185 |
| Sand | 185- 215 |
| Reamed to 13 3/4 | 1- 212 |
| Sand | 212-229 |
| Red Bed | 229- 247 |
| 247' of 10" casing | |
| Red Bed & Shale | 247- 320 |
| Red Bed, Shale, Red Rock | 320- 575 |
| Anhydrite | 575- 615 |
| Shale & Shells | 615- 650 |
| Lime, Shale | 650- 795 |
| Shale, Shells, Salt | 795- 885 |
| Shale & Lime | 885- 975 |
| Shale & Shells | 975-1070 |
| Shale & Shells, Salt | 1070-1385 |
| Anhydrite, Shale | 1385-1425 |
| Anhydrite, Shale break | 1425-1500 |
| Anhydrite | 1500-1570 |
| Hard Lime | 1570-1590 |
| Anhydrite & Sandy Lime | 1590-1635 |
| Sandy Lime & Shale | 1635-1705 |
| Lime & Shale | 1705-1755 |
| Sandy Lime | 1755-1770 |
| Broken Line | 1770-1810 |
| Fort Riley - 1700 | |
| Florence Sand - 1805 | |
| Lime, Sandy | 1810-1860 |
| Lime | 1860-1920 |
| Lime & Shale | 1920-2105 |
| Lime | 2105-2145 |
| Shale & Shells | 2145-2185 |
| Lime | 2185-2215 |
| Shale | 2215-2235 |
| Shale & Shells | 2235-2435 |
| Shale & Lime | 2435-2620 |
| Shale | 2620-2665 |
| Lime & Shale | 2665-2755 |
| Lime | 2755-2950 |
| Topeka Lime - 2785 | |
| Lime & Shale | 2950-2975 |
| Lime Hard | 2975-3000 |
| Lime | 3000-3035 |

| FORMATION | DEPTH |
|---|---------------|
| Lime & Shale | 3035-3090 |
| Shale | 3090-3180 |
| Lime | 3180-3425 |
| Lansing K.C. | 3175 |
| Red Rock & Green Shale | 3425-3445 |
| Variegated Shale, Chert | 3445-3450 |
| SIM 3429 - o.k. | |
| Circulating | |
| Cored 3450-3457 1/2 | |
| Recovery: | |
| Shale Green | 3450-3452 |
| Sand, Fine, clear with green shale and slight show of oil | 3452-3455 |
| Shale Green | 3455-3457 |
| Dolomite, tan to grey dense in part, sandy broken with green shale slight show of oil | 3457-3457 1/2 |
| Top Arbuckle Siliceous | 3456 |
| Second core recovery: | |
| Dolomite, tan to brown fine to medium crystalline, good spotted porosity, fair saturation | 3458-3463 |

Run and cemented 7" at 3456'
 Acidized with 120 gal. to clean hole.

Line 3464-3470
 Bailed oil & water
 Acidized with 500 gal.
 Swabbed and bailed.

Swabbing gauge:

| | |
|-------------------|----------|
| 1st. hr. two runs | 8.4 Bbl. |
| 2nd. hr. 3 " | 6.5 |
| 3rd. hr. 2 " | 3.4 |
| 4th. hr. 2 " | 2.5 |
| 5th. hr. 2 " | 2.5 |

Swabbing gauge following day:

| | |
|------------------|-----|
| 1st. hr. 2 runs | 4.2 |
| 2nd. hr. 2 " | 4.2 |
| 3rd. hr. 1 3/4 " | 3.4 |
| 4th. hr. 1 " | 2.5 |
| 5th. hr. 2 " | 2.5 |

Acidized with 800 gal.
 Swabbed hole dry.


Swabbing gauge following day:

| | |
|-----------------|------------|
| 1st. hr. 2 runs | 10.00 bbl. |
| 2nd. hr. 2 " | 5.9 |
| 3rd. hr. 2 " | 4.2 |
| 4th. hr. 2 " | 2.5 |

Swabbed hole dry.

Arbuckle Line 3470-3563
 Nowater - no oil

Arbuckle Line 3563-3580 T. D.
 Water at 3575.

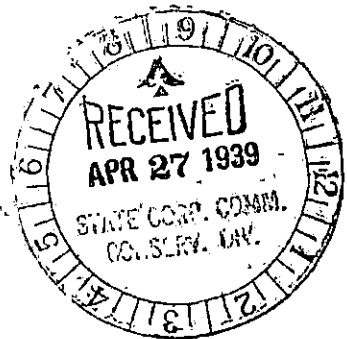

PLUGGING
 FILE SEC. 7-21-R-11W
 BOOK PAGE 57 LINE 31

