

WELL PLUGGING RECORD

STATE OF KANSAS STATE CORPORATION COMMISSION


Give All Information Completely Make Required Affidavit Mail or Deliver Report to: Conservation Division State Corporation Commission 800-Bitting Building Wichita, Kansas

OR

FORMATION PLUGGING RECORD

Strike out upper line when reporting plugging of formations.

Stafford County. Sec. 7 Twp. 21 Rge. (E) 11 (W) Location as "NE 1/4 NW 1/4 SW 1/4" or footage from lines NW 1/4 SW 1/4 NE 1/4 Lease Owner Musgrove Petroleum Corporation Lease Name Schlochtermeyer Well No. 1-A Office Address 407 K.F.H. Building, Wichita 2, Kansas Character of Well (completed as Oil, Gas or Dry Hole) Dry Hole Date well completed 8-7-48 19 Application for plugging filed 9-28-48 19 Application for plugging approved 9-28-48 19 Plugging commenced 9-29-48 19 Plugging completed 10-2-48 19 Reason for abandonment of well or producing formation Dry

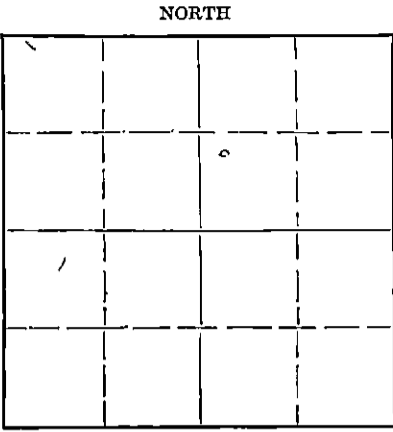

Locate well correctly on above Section Plat

Name of Conservation Agent who supervised plugging of this well C. D. Stough Producing formation Depth to top Bottom Total Depth of Well 3481 Feet Show depth and thickness of all water, oil and gas formations.

OIL, GAS OR WATER RECORDS

CASING RECORD

Table with 7 columns: Formation, Content, From, To, Size, Put In, Pulled Out. Contains two entries for casing sizes 8-5/8 and 5-1/2.

Describe in detail the manner in which the well was plugged, indicating where the mud fluid was placed and the method or methods used in introducing it into the hole. If cement or other plugs were used, state the character of same and depth placed, from feet to feet for each plug set.

Set Bridge at 3240. Dumped 5 sacks of cement on top of Bridge with dump bailor. Shot off and pulled 2663' of 5 1/2" casing. Filled hole to 275 feet with mud. Set Bridge at 275' and dumped 15 sacks of cement at 275'. Filled hole to 20' with mud and dumped 10 sacks of cement in top of surface pipe.

1948 10-19-48

(If additional description is necessary, use BACK of this sheet)

Correspondence regarding this well should be addressed to Musgrove Petroleum Corporation Address 407 K.F.H. Building Wichita 2, Kansas

STATE OF KANSAS, COUNTY OF SEDGWICK, ss. P. C. Musgrove (employee or owner or operator) of the above-described well, being first duly sworn on oath, says: That I have knowledge of the facts, statements, and matters herein contained and the log of the above-described well as filed and that the same are true and correct. So help me God.

(Signature) P. C. Musgrove 407 K.F.H. Bldg., Wichita 2, Kansas (Address)

SUBSCRIBED AND SWORN to before me this 13th day of October, 1948

Nadine J. Irwin Notary Public.

My commission expires December 5, 1951

Handwritten notes and stamps including '7-21-48' and 'ROCK PAGE 59 LINE 28'.

MUSGROVE PETROLEUM CORPORATION  
407 K. F. H. Building  
Wichita, Kansas

Contractors:  
Crown Oil Company, Inc.  
2421 Tenth St.,  
Great Bend, Kansas

Schlochtermeyer "A" #1 well  
NW SW NE, Sec. 7-21-11  
Stafford County, Kansas

Commenced: 7-11-48  
Completed: 7-26-48  
Casing: 8 5/8" 284' 150 sacks with 2% jell

Figures indicate bottom of formation:

0	to	70	Sand
70		275	Shale and sand
275		345	Red bed
345		585	Shale and shells.
585		610	Anhydrite
610		700	Shale and Red Bed
700		1155	Shale
1155		1185	Salt
1185		1580	Salt lime and shale
1580		1765	Lime
1765		2185	Lime and shale
2185		2258	Lime with shale breaks
2258		2670	Shale and lime
2670		2775	Shale
2775		3053	Lime
3053		3130	Lime and shale breaks
3130		3174	Lime and shale
3174		3385	Lime
3385		3444	Lime and shale
3444		3473	Lime (cherty)
		3473	Total Depth

Geologist Tops:  
Elevation: ----- 1823 D.F.  
Heebner: ----- 3041  
Lansing Kansas City: 3182  
Conglomerate: ----- 3414  
Simpson: ----- 3421  
Arbuckle: ----- 3465  
Rotary Total Depth: 3473

\*\*\*\*\*

State of Kansas )  
County of Barton ) ss

I, the undersigned, being duly sworn on oath state that the above statement and log is a true and correct record and log of the well drilled at the location above described.

CROWN OIL COMPANY, Inc.

By Sam H. Clark

Subscribed and sworn to before me this 29th day of November, 1948.

Grace C. Jacobs  
Notary Public

My commission expires June 2, 1952

RECEIVED

**PLUGGING**  
FILE SEC 7 T 21 R 11W  
BLOCK PAGE 59 LINE 28

DEC 11 1948  
COMMISSION  
KANSAS

15.185.12454.0000

MUSGROVE PETROLEUM CORPORATION  
407 K. F. H. Building  
Wichita, Kansas

Contractors:  
Crown Oil Company, Inc.  
2421 Tenth St.,  
Great Bend, Kansas

Schlochtermeyer "A" #1 well  
NW SW NE, Sec. 7-21-11  
Stafford County, Kansas

Commenced: 7-11-48  
Completed: 7-26-48  
Casing: 8 5/8" 284' 150 sacks with 2% jell

Figures indicate bottom of formation:

0	to	70	Sand
70		275	Shale and sand
275		345	Red bed
345		585	Shale and shells
585		610	Anhydrite
610		700	Shale and Red Bed
700		1155	Shale
1155		1185	Salt
1185		1580	Salt lime and shale
1580		1765	Lime
1765		2185	Lime and shale
2185		2258	Lime with shale breaks
2258		2670	Shale and lime
2670		2775	Shale
2775		3053	Lime
3053		3130	Lime and shale breaks
3130		3174	Lime and shale
3174		3385	Lime
3385		3444	Lime and shale
3444		3473	Lime (cherty)
		3473	Total Depth

Geologist Tops:  
Elevation: ----- 1823 D.F.  
Heebner: ----- 3041  
Lansing Kansas City: 3182  
Conglomerate: ----- 3414  
Simpson: ----- 3421  
Arbuckle: ----- 3465  
Rotary Total Depth: 3473

\*\*\*\*\*

State of Kansas )  
County of Barton ) ss

I, the undersigned, being duly sworn on oath state that the above statement and log is a true and correct record and log of the well drilled at the location above described.

CROWN OIL COMPANY, Inc.

By Ran D. Cook

Subscribed and sworn to before me this 29th day of November, 1948.

Greene E. Jacobs  
Notary Public

My commission expires June 2, 1952

RECEIVED  
DEC 1 1948  
STAFFORD COUNTY  
COMMISSIONER  
KANSAS