


STATE OF KANSAS
STATE CORPORATION COMMISSION

Give All Information Completely
Make Required Affidavit
Mail or Deliver Report to:
Conservation Division,
State Corporation Commission
211 No. Broadway
Wichita, Kansas

WELL PLUGGING RECORD

STAFFORD County. Sec. 30 Twp. 21 Rge. (E) 11 (W)
Location as "NE/CNW/SW" or footage from lines SE NW SE
Lease Owner WESTERN PETROLEUM CO., INC.
Lease Name HULLMAN Well No.
Office Address 925 PATTON ROAD
Character of Well (completed as Oil, Gas or Dry Hole) DRY HOLE
Date well completed MAY 31, 19 62
Application for plugging filed MAY 31, 19 62
Application for plugging approved MAY 31, 19 62
Plugging commenced JUNE 1 2:00 A.M. 19 62
Plugging completed JUNE 1 3:30 A.M. 19 62
Reason for abandonment of well or producing formation DRY HOLE

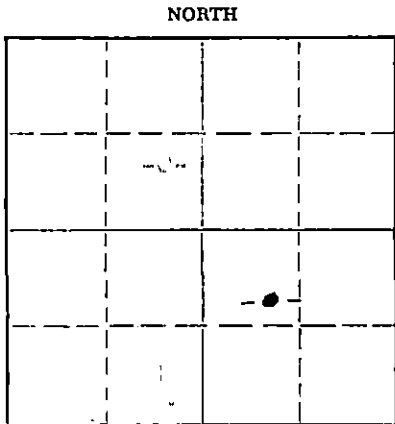

Locate well correctly on above Section Flat

If a producing well is abandoned, date of last production 19
Was permission obtained from the Conservation Division or its agents before plugging was commenced? YES

Name of Conservation Agent who supervised plugging of this well W. L. LA CAMP, STAFFORD
Producing formation Depth to top Bottom Total Depth of Well 3550' Feet
Show depth and thickness of all water, oil and gas formations.

OIL, GAS OR WATER RECORDS

CASING RECORD

FORMATION	CONTENT	FROM	TO	SIZE	PUT IN	PULLED OUT
		0	208	8-5/8"	5/22/62	

Describe in detail the manner in which the well was plugged, indicating where the mud fluid was placed and the method or methods used in introducing it into the hole. If cement or other plugs were used, state the character of same and depth placed, from feet to feet for each plug set.

FILLED HOLE TO 180' WITH ROTARY MUD. PUSHED WOODEN PLUG AND HULLS TO FLUID.

CEMENTED THROUGH DRILL PIPE WITH 20 SXS. OF COMMON CEMENT.

FILLED HOLE TO 35' WITH ROTARY MUD. PUSHED WOODEN PLUG AND HULLS TO FLUID.
CEMENTED WITH 10 SXS. OF COMMON CEMENT.

JOB COMPLETED @ 3:30 A.M. 6/1/62

RECEIVED
STATE CORPORATION COMMISSION
JUN 4 1962
CONSERVATION DIVISION
Wichita, Kansas

(If additional description is necessary, use BACK of this sheet)

Name of Plugging Contractor
Address

STATE OF KANSAS, COUNTY OF BARTON, ss.
F. L. COPELAND (employee of owner) or (owner or operator) of the above-described

well, being first duly sworn on oath, says: That I have knowledge of the facts, statements, and matters herein contained and the log of the above-described well as filed and that the same are true and correct. So help me God.

(Signature) F. L. Copeland

(Address)

SUBSCRIBED AND SWORN TO before me this 15th day of JUNE 19 62

Janice M. Becker
Notary Public.

My commission expires JUNE 27, 1962



DRILLERS LOG

#1 HULLMAN

CASING RECORD: 5 JTS 8-5/8" 20# PIPE.	COMPANY: WESTERN PETROLEUM Co., INC.	DESCRIPTION: SE NW SE SECTION 30-T21S-R11W STAFFORD COUNTY, KANSAS.
TOTAL DEPTH: 3550'	CONTRACTOR: WESTERN PETROLEUM Co., INC.	ELEVATION: 1766' DF 1769' KB
	COMMENCED: MAY 22, 1962	
	COMPLETED: JUNE 1, 1962	

<u>FORMATION</u>	<u>FROM</u>	<u>TO</u>	<u>REMARKS</u>
SURFACE CLAY AND SAND	0	15	SPUD 11:45 AM 5/22/62. RAN 5 JTS 8-5/8" 20# NEW PIPE (203.73'). SET AT 208' w/ 170 SXS POZMIX HA5 HALLUBURTON w/ FLOW SEAL ADDED. PLUG DOWN 4:50 PM 5/22/62.
SAND AND GRAVEL	15	135	
RED BED AND SHALE	135	515	DST #1 3178 - 3232'. Op. 90". WEAK STEADY BLW THROUGHOUT. REC. 180' VISIBLE GAS AND 60' O&GCM (OIL WAS BLACK AND INERT). IBHP 810#/30", FBHP 170#/30", IFP 30#, FFP 40# HH 1745#
ANHYDRITE	515	534	
SHALE AND SHELLS	534	1350	
LIME AND SHALE	1350	1930	
SHALE AND LIME	1930	2120	
LIME AND SHALE	2120	2495	
SHALE AND LIME	2495	2750	
LIME AND SHALE	2750	2965	
LIME	2965	3022	
LIME AND SHALE	3022	3232	
LIME	3232	3273	DST #2 3232 - 3273'. Op. 54". WEAK BLW 24". REC. 45' WATERY MUD w/ FEW OIL SPECKS. IBHP 1045#/30", FBHP 695#/30" IFP 35# FFP 50#, HH 1730#
LIME AND SHALE	3273	3323	
LIME	3323	3445	DST #3 3450 - 3475'. Op. 38". WEAK BLW 8". REC. 5' ROTARY MUD. IBHP 870#/30" FBHP 695#/30", IFP - FFP 0#, HH 1870#
CHERTY LIME	3445	3475	
CHERTY LIME AND SHALE	3475	3526	DST #4 3524 - 29'. Op. 35". WEAK BLW 5". REC. 4' MUD. IBHP 1005#/30", FBHP 840#/30", IFP - FFP 0#, HH 1800#
ARBUCKLE	3526	3550	
RTD	3550		DST #5 3470 - 3529'. Op. 75". Good BLW DECLINING TO FAIR BLW. REC. 1980' FORMATION WTR. NS. IBHP 1000#/30", FBHP 965#/30", IFP 370#, FFP 880#, HH 1870#.
SAMPLE TOPS			
ANHYDRITE	515	1254	DST #6 3540 - 50'. Op. 75". FAIR BLW. REC. 615' FORMATION WTR. IBHP 1165#/30" FBHP 1120#/30", IFP 55#, FFP 280#, HH 1885#.
HEEBNER	3024	-1255	
IATAN	3154	-1385	RTD 3550'. D & A SCHLUMBERGER RAN INTERGRATED SONIC GAMMA RAY CALIPER AND LATEROLOG SURVEY LOGS.
LANSING	3170	-1401	
B/KC	3416	-1647	
CONGLOMERATE	3425	-1656	
VIOLA	3441	-1672	
SIMPSON	3478	-1709	
ARBUCKLE	523	-1754	

RECEIVED
STATE CORPORATION COMMISSION

JUN 7 1962

CONSERVATION DIVISION
Wichita, Kansas

STATE OF KANSAS }
 } SS
COUNTY OF BARTON }

I, THE UNDERSIGNED, BEING DULY SWORN ON OATH, STATE THAT THE ABOVE STATEMENT AND LOG ARE TRUE AND A CORRECT RECORD AND LOG OF THE WELL DRILLED AT THE LOCATION ABOVE DESCRIBED.

WESTERN PETROLEUM CO., INC.

F. L. Copeland
F. L. COPELAND, DRLG. SUPT.

SUBSCRIBED AND SWORN TO BEFORE ME THIS 5TH DAY OF JUNE, 1962.

Janice M. Becker
JANICE M. BECKER, NOTARY PUBLIC

MY COMMISSION EXPIRES: JUNE 27, 1965