

STATE OF KANSAS  
STATE CORPORATION COMMISSION

Form CP-4

WELL PLUGGING RECORD

Give All Information Completely  
Make Required Affidavit  
Mail or Deliver Report to:  
Conservation Division  
State Corporation Commission  
212 No. Market  
Wichita, Kansas

Stafford County. Sec. 30 Twp. 21 Rge. 11 (W)

Location as "NE/CNW&SW" or footage from lines. NE SW SW

Lease Owner H.C. Bennett

Lease Name Duggan Well No. #1

Office Address 1212 Union National Bldg. Wichita, Ks.

Character of Well (completed as Oil, Gas or Dry Hole) Oil Well

Date well completed \_\_\_\_\_ 19\_\_

Application for plugging filed 7-1-66 19\_\_

Application for plugging approved 7-5-66 19\_\_


Plugging commenced 7-18-66 19\_\_

Plugging completed 7-27-66 19\_\_

Reason for abandonment of well or producing formation depleted

If a producing well is abandoned, date of last production \_\_\_\_\_ 19\_\_

Was permission obtained from the Conservation Division or its agents before plugging was commenced? yes

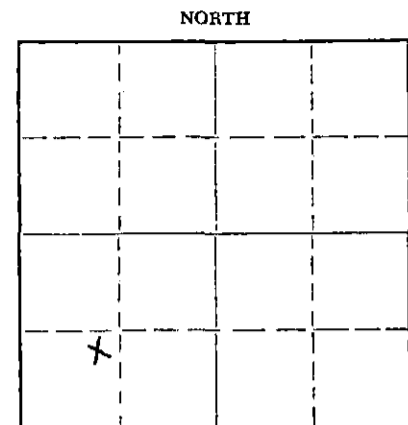

Locate well correctly on above Section Plat

Name of Conservation Agent who supervised plugging of this well Archie Elving

Producing formation \_\_\_\_\_ Depth to top \_\_\_\_\_ Bottom \_\_\_\_\_ Total Depth of Well 3578 Feet

Show depth and thickness of all water, oil and gas formations.

OIL, GAS OR WATER RECORDS

CASING RECORD

FORMATION	CONTENT	FROM	TO	SIZE	PUT IN	PULLED OUT
				8 5/8	240'	none
				5 1/2	3548'	2730'

Describe in detail the manner in which the well was plugged, indicating where the mud fluid was placed and the method or methods used in introducing it into the hole. If cement or other plugs were used, state the character of same and depth placed, from \_\_\_\_\_ feet to \_\_\_\_\_ feet for each plug set.

Set 20' rock bridge from 3400' to 3380' and dump 5 sacks of cement

Set 10' rock bridge from 235' to 225' and mix and dump 2 sacks of calseal and 3 sacks of cement - let set over night

Bail hole dry to bridge and dump 22 sacks of cement, mud hole to 40', rock to 35' and dump 10 sacks of cement to surface

STATE CORPORATION COMMISSION  
AUG 12 1966  
8-12-66  
CONSERVATION DIVISION  
Wichita, Kansas

(If additional description is necessary, use BACK of this sheet)

Name of Plugging Contractor Flint Engineering and Const. Co.

Address 2375 W. Central El Dorado, Kansas

STATE OF Kansas, COUNTY OF Butler, ss.

\_\_\_\_\_, (employee of owner) or (owner or operator) of the above-described well, being first duly sworn on oath, says: That I have knowledge of the facts, statements, and matters herein contained and the log of the above-described well as filed and that the same are true and correct. So help me God.

(Signature) James Davis

(Address)

SUBSCRIBED AND SWORN TO before me this 9 day of August, 19 66

My commission expires Sept. 27, 1967

Ronald R. Hansen

Notary Public.


15.185.00449.0000

WELL LOG BUREAU KANSAS GEOLOGICAL SOCIETY  
503 East Muldock, Wichita, Kansas

Company: PICKRELL DRILLING COMPANY, INC., et al SEC. 30 T. 21 R. 11W  
Farm: Duggan No. 1 NE SW SW

Total Depth. 3578  
Comm. 11-9-50 Comp. 12-3-50  
Shot or Treated:  
Contractor: Pickrell Drilg Co., Inc.  
Issued: 9-27-52

County Stafford  
KANSAS

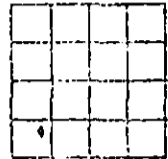

CASING:  
8 5/8" 240' cem w/150 sz in 12 1/4" hole  
5 1/2" 354' cem w/100 sz in 7 7/8" hole

Elevation: 1785

Production: 170 bbls

Yds. from top rotary washing: (rest of text is faint)

- cellar 0
- sand 120
- rock 240
- redd, shale 30
- shale, red bed 1060
- lim. 1 75
- shale, salt 1 75
- lim, shale 2 70
- lim 2 70
- LOST HOLE
- fill with cement
- back to 2638
- Drilled with East-
- man survey.
- lime, shale 2958
- lim 2 70
- lim, shale 3170
- lim 3210
- conductor pit 3 70
- lime 3 70 - RTD
- lim 3578


RECEIVED  
AUG 12 1966  
CONSERVATION DIVISION  
WICHITA, KANSAS

Bridge @ 3400 @ 5 Saf