


STATE OF KANSAS
STATE CORPORATION COMMISSION

WELL PLUGGING RECORD

Give All Information Completely
Make Required Affidavit
Mail or Deliver Report to:
Conservation Division
State Corporation Commission
800 Bitting Building
Wichita, Kansas

Stafford County. Sec. 30 Twp 21S Rge 11 (E) W (W)
Location as "NE/CNW $\frac{1}{4}$ SW $\frac{1}{4}$ " or footage from lines SE SE SW
Lease Owner The Vickers Petroleum Company, Inc.
Lease Name Duggan Well No. 2
Office Address 201 W.K.H. Bldg., Wichita, Kansas
Character of Well (completed as Oil, Gas or Dry Hole) Dry
Date well completed March 20, 19 51
Application for plugging filed March 20, 19 51
Application for plugging approved March 20, 19 51
Plugging commenced March 20, 19 51
Plugging completed March 20, 19 51
Reason for abandonment of well or producing formation

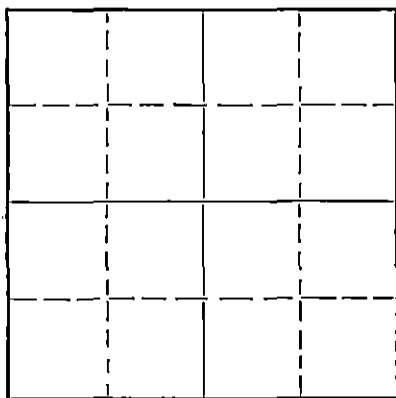

Locate well correctly on above
Section Plat

If a producing well is abandoned, date of last production 19
Was permission obtained from the Conservation Division or its agents before plugging was commenced? yes

Name of Conservation Agent who supervised plugging of this well Mr. C. D. Stough, Box 207, Great Bend, Kansas
Producing formation Depth to top Bottom Total Depth of Well 3570 Feet
Show depth and thickness of all water, oil and gas formations.

OIL, GAS OR WATER RECORDS

CASING RECORD

Formation	Content	From	To	Size	Put In	Pulled Out
				8-5/8"	280	None

Describe in detail the manner in which the well was plugged, indicating where the mud fluid was placed and the method or methods used in introducing it into the hole. If cement or other plugs were used, state the character of same and depth placed, from feet to feet for each plug set.

Filled hole w/mud to 270' Dump 15 sx. cement @ 270' Filled w/mud to 35'. Set plug and dump 10 Sx. cement @ 35'. Filled to bottom of cellar.

RECEIVED
STATE CORPORATION COMMISSION
MAR 20 1951
CONSERVATION DIVISION
WICHITA, KANSAS
3-30-51

(If additional description is necessary, use BACK of this sheet)

Correspondence regarding this well should be addressed to The Vickers Petroleum Co., Inc.
Address 201 W.K.H. Bldg., Wichita, Kansas

STATE OF Kansas, COUNTY OF Sedgwick, ss.
John M. Little (employee of owner) or (owner or operator) of the above-described well,
being first duly sworn on oath, says: That I have knowledge of the facts, statements, and matters herein contained and the log of the above-described well as filed and that the same are true and correct. So help me God.

(Signature) [Signature]
201 W-K-H Bldg., Wichita, Kansas (Address)

SUBSCRIBED AND SWORN TO before me this 28th day of March, 19 51

[Signature] Notary Public.

My commission expires August 13, 1953.

PLUGGING
FILE SEC 30 T 21 R 11W
BOOK PAGE 68 LINE 33

THE VICKERS PETROLEUM CO., INC.

Duggan Well #2
SE SE¹SW Sec. 30-21S-11W
Stafford County, Kansas

Casing Record:
8-5/8" @ 280' w/200 sx

Commenced: March 6, 1951
Completed: March 20, 1951

Elevation: 1772 R.B.

D. & A.

LOG

Surface & Sand	0-40
Sand	40-110
Red Beds	110-520
Anhydrite	520-545
Shale, Shells & Red Beds	545-790
Shale & Shells	790-1060
Shale, Shells & Salt	1060-1160
Salt, Shale & Shells	1160-1375
Lime Broken	1375-1470
Lime	1470-1650
Lime Broken & Sand	1650-1670
Lime Broken	1670-1910
Lime & Shale	1910-2805
Lime	2805-3066
Shale	3066-3166
Lime & Shale	3166-3456
Conglomerate	3456-3570 TD

D.S.T. 3455-3487 open 20 min. very weak
blow Rec'd 15' mud B.H.P. 970#
D.S.T. 3500-3540 open 20 min. weak blow
17 min. Rec'd 20' mud

Tops:
Heebner 3031'
Douglas 3066'
Brown Lime 3166'
Lansing 3185'
Conglomerate 3456'

I hereby certify that this log is true and correct to the best of my knowledge and belief.

Sworn and subscribed to before me
this 26th day of March, 1951.

Allen J. Denton
Notary Public

My commission expires Aug. 13, 1953.

THE VICKERS PETROLEUM CO., INC.

BY

W. P. Simmons
RECEIVED
STATE CORPORATION COMMISSION

MAR 30 1951

CONSERVATION DIVISION
Wichita, Kansas

