


STATE OF KANSAS
STATE CORPORATION COMMISSION

Form CP-4

Give All Information Completely
Make Required Affidavit
Mail or Deliver Report to:
Conservation Division
State Corporation Commission

WELL PLUGGING RECORD

P. O. Box 17027
Wichita, Kansas 67217
NORTH

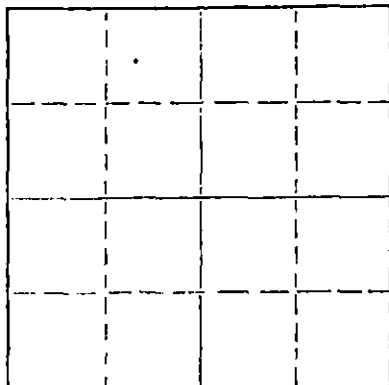

Locate well correctly on above
Section Plat

Stafford County. Sec. 30 Twp. 21S Rge. 11 (E) (W) X
Location as "NE/CNWxSWx" or footage from lines NW NW SW
Lease Owner Utica Southern Exploration, Inc.
Lease Name Duggan Well No. 1
Office Address 503 Mayo Building Tulsa, Oklahoma 74103
Character of Well (completed as Oil, Gas or Dry Hole) D & A
Date well completed February 11 19 74
Application for plugging filed February 11 19 74
Application for plugging approved February 11 19 74
Plugging commenced February 11 19 74
Plugging completed February 11 19 74
Reason for abandonment of well or producing formation D & A

If a producing well is abandoned, date of last production _____ 19 ____
Was permission obtained from the Conservation Division or its agents before plugging was commenced? Yes

Name of Conservation Agent who supervised plugging of this well Mr. G. R. Biberstei
Producing formation _____ Depth to top _____ Bottom _____ Total Depth of Well 3645' Feet
Show depth and thickness of all water, oil and gas formations.

OIL, GAS OR WATER RECORDS

CASING RECORD

FORMATION	CONTENT	FROM	TO	SIZE	PUT IN	PULLED OUT
				8-5/8"	258'	-0-
<p>RECEIVED STATE CORPORATION COMMISSION FEB 26 1974 CONSERVATION DIVISION Wichita, Kansas</p>						

Describe in detail the manner in which the well was plugged, indicating where the mud fluid was placed and the method or methods used in introducing it into the hole. If cement or other plugs were used, state the character of same and depth placed, from _____ feet to _____ feet for each plug set.

40 sx cmt mudded up to 500'
25 sx cmt to 250'
Put in Bridge @ 40' 15 sx cmt.
2 sx cmt in rat hole


(If additional description is necessary, use BACK of this sheet)
Name of Plugging Contractor Red Tiger Drilling Company
Address 1720 Wichita Plaza, Wichita, Kansas 67202

STATE OF Kansas, COUNTY OF Sedgwick, ss.
D'Ann Drennan (employee of owner) or (owner or operator) of the above-described

well, being first duly sworn on oath, says: That I have knowledge of the facts, statements, and matters herein contained and the log of the above described well as filed and that the same are true and correct. So help me God.

(Signature) D'Ann Drennan
1720 Wichita Plaza, Wichita, Kansas 67202
(Address)

Sworn to before me this 15th day of February, 19 74

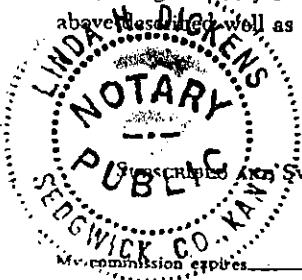

March 8, 1977

Linda H. Dickens

Notary Public.

15.185.20479.0000

DRILLERS LOG

No. 1 Duggan

CASING RECORD:

3-5/8" @ 250'
w/225 sx cmt

TOTAL DEPTH: 3645'

COMPANY: Utica Southern Exploration, Inc.

CONTRACTOR: Red Tiger Drilling Co.

COMMENCED: January 29, 1974

COMPLETED: February 10, 1974

DESCRIPTION:

NW NW SW
30-21S-11W
Stafford County
Kansas

ELEVATION: 1792 G.L.

RECEIVED
STATE CORPORATION COMMISSION

FEB 26 1974

CONSERVATION DIVISION
Wichita, Kansas

<u>FORMATION</u>	<u>FROM</u>	<u>TO</u>	<u>REMARKS</u>
Sand	0	180	
Shale	180	550	
Anhydrite	550	569	
Shale & Shells	569	1375	
Shale & Lime	1375	1835	
Lime	1835	2120	
Lime & Shale	2120	3065	
Shale	3065	3180	
Lime	3180	3546	
Dolomite & Shale	3546	3574	
Dolomite	3574	3645	

I certify that this is a true and correct copy of the above log to the best of my knowledge.

RED TIGER DRILLING COMPANY

D'Ann Drennan
D'Ann Drennan

Subscribed and sworn to before me this 15th day of February, 1974.

Linda H. Dickens
Notary Public

My Commission Expires:

March 8, 1977

