

WELL PLUGGING RECORD

Give All Information Completely  
Make Required Affidavit  
Mail or Deliver Report to:  
Conservation Division  
State Corporation Commission  
800 Biting Building  
Wichita, Kansas

Stafford County, Sec. 30 Twp. 21 Rge. 11W (E) (W)

Location as "NE/CNW<sup>1</sup>/<sub>4</sub>SW<sup>1</sup>/<sub>4</sub>" or footage from lines SW SW SW

Lease Owner Pickrell Drilling Co. Inc. et al

Lease Name Duggan Well No. 2

Office Address 705 4th Natl. Bank Bldg., Wichita, Ks.

Character of Well (completed as Oil, Gas or Dry Hole) Lost Hole

Date well completed 12/27/ 19 50

Application for plugging filed 12/27 19 50

Application for plugging approved 12/27 19 50


Plugging commenced 12/27 19 50

Plugging completed 12/27 19 50

Reason for abandonment of well or producing formation Lost drill pipe in hole - could not complete drilling.

If a producing well is abandoned, date of last production 19

Was permission obtained from the Conservation Division or its agents before plugging was commenced? Yes

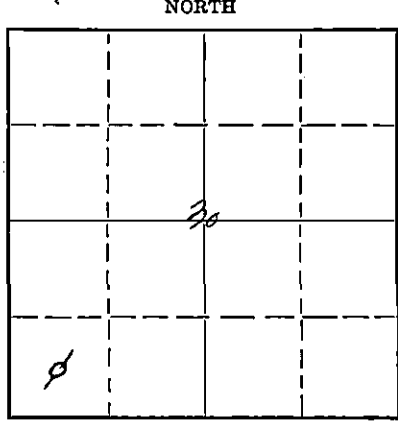

Locate well correctly on above Section Plat

Name of Conservation Agent who supervised plugging of this well

Producing formation Depth to top Bottom Total Depth of Well 2365 Feet

Show depth and thickness of all water, oil and gas formations.

OIL, GAS OR WATER RECORDS

CASING RECORD

Formation	Content	From	To	Size	Put In	Pulled Out
				8 5/8"	242	None
				No oil string of casing run.		

Describe in detail the manner in which the well was plugged, indicating where the mud fluid was placed and the method or methods used in introducing it into the hole. If cement or other plugs were used, state the character of same and depth placed, from feet to feet for each plug set.

Fill hole with heavy mud to 230', dump 15 sax cement, fill wf mud to 30', dump 10 sax cement to bottom cellar.

Left approx. 600' of drill pipe and 2 - 30' drill collars in hole - could not fish out.

(If additional description is necessary, use BACK of this sheet)

Correspondence regarding this well should be addressed to Pickrell Drilling Co. Inc.

Address 705 4th Natl. Bank Bldg., Wichita, Ks.

STATE OF Kansas, COUNTY OF Sedgwick, ss.

C. W. Sebitt (employee of owner) or (owner's representative) of the above-described well,

being first duly sworn on oath, says: That I have knowledge of the facts, statements, and matters herein contained and the log of the above-described well as filed and that the same are true and correct. So help me God.

(Signature) C. W. Sebitt

705 4th Natl. Bank Bldg. Wichita, Ks. (Address)

SUBSCRIBED AND SWORN to before me this January 19 51 day of

Ethel Zimmerman Notary Public.

My commission expires Jan 28, 1953

PLUGGING  
FILE SEC. 30 T. 21 R. 11W  
BOOK PAGE 51 LINE 37

15.185.13095.0000

COMPANY: PICKRELL DRILLING COMPANY INC. ET AL Rotary Drlg. Commenced: 12/14/50  
 Wichita, Ks. Rotary Drlg. Completed: 12/18/50  
 Fishing: 12/19/50 to 12/27/50

LOCATION: Duggan #2, SW SW SW 30-21-11W  
 Stafford County, Ks.

CONTRACTOR: PICKRELL DRILLING COMPANY, INC.  
 Wichita, Ks.

CASING RECORD: 242' - 6 jts. 8 5/8" New Casing set at 242' in 12 1/4" hole  
 with 150 sax cement.  
 No oil string of casing run.

L O G

Figures are bottom of formation - measurements from top rotary bushing.

Cellar	5	
Sand	115	
Red Bed, Gray Shale	170	
Red Bed	240	
Shale	550	
Anhydrite	590	
Shale	650	
Shale & Salt	1220	
Shale & Shells	1555	
Lime & Shale	2365	Rotary T.D.

Lost approx. 600' of drill pipe and 2-30' drill collars in hole - could not fish out - Skid over.

The undersigned, C. W. Sebitts, Secretary of Pickrell Drilling Company, Inc., hereby certifies in behalf of said corporation, that the above log is a true and correct log of the formation encountered in drilling the above well as reflected by the Daily Drilling Reports.

PICKRELL DRILLING COMPANY, INC.

By C. W. Sebitts  
Secy.

STATE OF KANSAS )  
                          ) ss  
COUNTY OF SEDGWICK )

Be It Remembered that on this 4th day of January, 1951 before me, the undersigned, a Notary Public, duly commissioned, in and for the county and state aforesaid, came C. W. Sebitts, Secretary of Pickrell Drilling Company, Inc., a corporation of the State of Kansas, personally known to me to be such officer; and to be the same person who executed as such officer the foregoing instrument of writing in behalf of said corporation, and he duly acknowledged the execution of the same for himself and for said corporation.

IN WITNESS WHEREOF, I have hereunto set my hand and official seal on the day and year last above written.

Ethel Zimmerman  
Notary Public

My commission expires Jan. 28, 1953.

STATE OF KANSAS  
CORPORATION COMMISSION  
JAN 4 1951  
WICHITA DIVISION  
Wichita, Kansas

**PLUGGING**  
FILE SEC 30T 21 R 11W  
BOOK PAGE 51 LINE 37