

STATE OF KANSAS
STATE CORPORATION COMMISSION


WELL PLUGGING RECORD

Give All Information Completely
Make Required Affidavit
Mail or Deliver Report to:
Conservation Division
State Corporation Commission
211 N. Broadway
Wichita, Kansas

McPherson County, Sec. 13 Twp. 21 Rge. 2 (W)

Location as "NE/CNW/SW" or footage from lines SW SW SW
Lease Owner E. K. Carey Contractor
Lease Name Rupp Well No. 1
Office Address Box 620, McPherson, Kansas
Character of Well (completed as Oil, Gas or Dry Hole) Dry hole
Date well completed 12-21-1956 19
Application for plugging filed 12-21-1956 19
Application for plugging approved 12-21-1956 19
Plugging commenced 1:30 PM 12-21-1956 19
Plugging completed 3:30 PM 12-21-1956 19
Reason for abandonment of well or producing formation Dry hole

NORTH

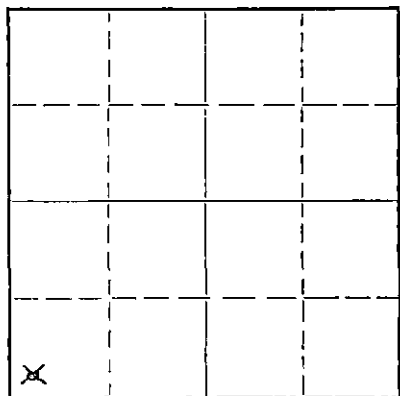

Locate well correctly on above
Section Plat

If a producing well is abandoned, date of last production _____ 19____
Was permission obtained from the Conservation Division or its agents before plugging was com-
menced? Yes

Name of Conservation Agent who supervised plugging of this well Ruel Durkee, McPherson, Kansas
Producing formation _____ Depth to top _____ Bottom _____ Total Depth of Well 3450 Feet
Show depth and thickness of all water, oil and gas formations.

OIL, GAS OR WATER RECORDS

CASING RECORD

FORMATION	CONTENT	FROM	TO	SIZE	PUT IN	PULLED OUT
				8-5/8	129	None

Describe in detail the manner in which the well was plugged, indicating where the mud fluid was placed and the method or methods used in introducing it into the hole. If cement or other plugs were used, state the character of same and depth placed, from 190-115 feet to 20-5 feet for each plug set.

Gunned pits and circulated heavy mud on bottom and layed down one half of drill pipe and circulated heavy mud at this point, layed down all but 6 joints of drill pipe. Ran measuring line and filled hole to 190' with heavy mud, made bridge with tree limb and rock to hold weight of 6 joints drill pipe. Mixed 25 sacks cement by Halliburton and pumped through 6 joints drill pipe. Layed down rest of drill pipe and filled with heavy mud to 20'. Put in plug and mixed 5 sacks cement and filled to bottom of cellar floor. Through plugging 3:30 PM., 12-21-56.

(If additional description is necessary, use BACK of this sheet)

Name of Plugging Contractor E. K. Carey Contractor
Address Box 620, McPherson, Kansas

STATE OF Kansas, COUNTY OF McPherson, ss.
Arland Bruce (employee of owner) or (owner or operator) of the above-described well, being first duly sworn on oath, says: That I have knowledge of the facts, statements, and matters herein contained and the log of the above-described well as filed and that the same are true and correct. So help me God.

(Signature) Arland Bruce
Box 620, McPherson, Kansas
(Address)

SUBSCRIBED AND SWORN TO before me this 22nd day of December, 19 56

My commission expires November 13, 1960

PLUGGING
FILE SEC 13 T 21 R 2W
BOOK PAGE 122 LI E 15

RECEIVED Notary Public
STATE CORPORATION COMMISSION

DEC 26 1956

CONSERVATION DIVISION
Wichita, Kansas

12-26-1956

"Opening up Old Hole"

ROTARY DRILLER'S LOG

E. K. Carey Contractor
Box 620
McPherson, Kansas

Elevations: 1499 K.B.

Rupp #1

Casing Record:

8-5/8" @ 129'

C, SW SW SW
Sec. 13-21-17 W
McPherson County, Kansas

Well Commenced: 12-17-1956
Well Completed: 12-21-1956 D & A

Contractor: E. K. Carey Contractor, Rig #2, Box 620, McPherson, Kansas
Geologist: Don Hollar, E. K. Carey Drlg. Co. 815 Central Bldg. Wichita

Figures Indicate Bottom of Formation K. B.

cement	28	Geologist Tops:	
cement, clean out old hole	168	Bs. Miss.	3254
clean out old hole	2834	Misner	3332
clean out old hole	3029	Hunton	3337
chat, Miss lime	3040	Maquoketa	3340
lime	3280	Viola	3434
shale	3339		
lime	3340		
Maquoketa lime and shale	3435	Rotary Total Depth	3450 <u>D&A</u>
lime	3450 TD		

This is to certify that the above information is to the best of my knowledge true and correct.

SUBSCRIBED AND SWORN to before me this 22nd day of December, 1956

E. K. CAREY CONTRACTOR

BY Herbert Rhoton
Herbert Rhoton, Superintendent

[Signature] NP

My Commission Expires:

November 13, 1960

PLUGGING
SEC. 13 T. 21 R. 3W
BOOK PAGE 28 LINE 15

RECEIVED
CORPORATION COMMISSION
DEC 26 1956
CONSERVATION DIVISION
Wichita, Kansas