

Nightingale #1


WELL PLUGGING RECORD

Give All Information Completely  
Make Required Affidavit  
Mail or Deliver Report to:  
Conservation Division  
State Corporation Commission  
212 No. Market  
Wichita, Kansas

McPherson County, Sec. 13 Twp. 21S Rge. 2W (EX) (W)

Location as "NE/CNW/SW" or footage from lines SE NE SW  
Lease Owner Beacon Resources Corporation  
Lease Name Nightingale #1 Well No.  
Office Address 312 Union Center Building, Wichita, Kansas 67202  
Character of Well (completed as Oil, Gas or Dry Hole) Dry Hole  
Date well completed January 1, 1969  
Application for plugging filed December 31, 1968  
Application for plugging approved December 31, 1968  
Plugging commenced 7:00 AM, January 1, 1969  
Plugging completed 9:00 AM, January 1, 1969  
Reason for abandonment of well or producing formation Dry Hole

NORTH

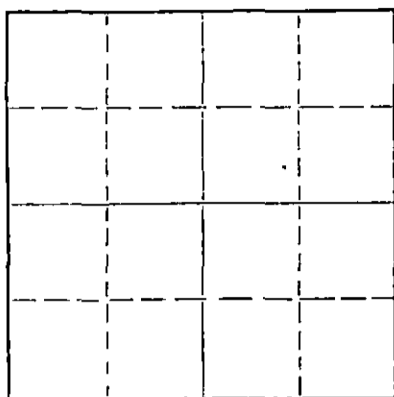

Locate well correctly on above Section Plat

If a producing well is abandoned, date of last production 19  
Was permission obtained from the Conservation Division or its agents before plugging was commenced? Yes

Name of Conservation Agent who supervised plugging of this well Gilbert Toman (Hugh Scott on vacation.)  
Producing formation Depth to top Bottom Total Depth of Well 3373' Feet  
Show depth and thickness of all water, oil and gas formations.

OIL, GAS OR WATER RECORDS

CASING RECORD

FORMATION	CONTENT	FROM	TO	SIZE	PUT IN	PULLED OUT
				8 5/8"	213.66'	None

RECEIVED  
STATE CORPORATION COMMISSION  
FEB 26 1969  
CONSERVATION DIVISION  
Wichita, Kansas

Describe in detail the manner in which the well was plugged, indicating where the mud fluid was placed and the method or methods used in introducing it into the hole. If cement or other plugs were used, state the character of same and depth placed, from feet to feet for each plug set.

Heavy mud to 200' with Howco Plug and 1/4 sack Hulls and 25 sacks Regular Cement. Heavy mud to 40' with Howco Plug and 1/4 sack Hulls and 10 sacks Regular Cement to Surface. Also 2 sacks in rathole.

(If additional description is necessary, use BACK of this sheet)

Name of Plugging Contractor Sterling Drilling Company  
Address P. O. Box 129, Sterling, Kansas 67579

STATE OF KANSAS, COUNTY OF RICE, ss.  
F. A. Wuellner (employee of owner) or (owner or operator) of the above-described well, being first duly sworn on oath, says: That I have knowledge of the facts, statements, and matters herein contained and the log of the above-described well as filed and that the same are true and correct. So help me God.

(Signature) F. A. Wuellner, Secretary  
STERLING DRILLING COMPANY  
P. O. Box 129, Sterling, Kansas 67579  
(Address)

SUBSCRIBED AND SWORN TO before me this 3rd day of January, 1969

Bernard Laudermilk, Notary Public.

My commission expires  
BERNARD LAUDERMILK, Notary Public  
Commission Expires January 22, 1970

15.113.20060.0000

STERLING DRILLING COMPANY  
P. O. Box 129  
Sterling, Kansas 67579

WELL Log ----- NIGHTINGALE #1  
LOCATED: SE NE SW, Sec. 13-21S-2W, McPherson County, Kansas

OWNER: Beacon Resources Corporation  
ROTARY DRILLING CONTRACTOR: Sterling Drilling Company

COMMENCED: December 21, 1968  
COMPLETED: January 1, 1969

TOTAL DEPTH: 3373'

<u>LOG</u>		<u>CASING RECORD</u>
0 - 30	Clay	Ran 11 joints 8 5/8" 28# Lapweld used seamless Casing. 213.66' Pipe set @ 221.16 K.B. Cemented with 200 sacks regular cement with 3% c.c. and 2% gel. Plug down at 1:30 AM, 12-22-68.
30 - 45	Sand	
45 - 228	Shale	
228 - 3005	Lime and Shale	
3005 - 3070	Lime and Chert	Flugged.
3070 - 3285	Lime	
3285 - 3354	Shale	
3354 - 3373	Lime	

RECEIVED  
STATE CORPORATION COMMISSION  
JAN 6 1969  
CONSERVATION DIVISION  
Wichita, Kansas

15.113.20060.0000

STERLING DRILLING COMPANY  
P. O. Box 129  
Sterling, Kansas 67579

WELL Log ----- NIGHTINGALE #1  
LOCATED: SE NE SW, Sec. 13-21S-2W, McPherson County, Kansas

OWNER: Beacon Resources Corporation  
ROTARY DRILLING CONTRACTOR: Sterling Drilling Company

COMMENCED: December 21, 1968  
COMPLETED: January 1, 1969

TOTAL DEPTH: 3373'

<u>LOG</u>	<u>CASING RECORD</u>
0 - 30 Clay	Ran 11 joints 8 5/8" 28# Lapweld used seamless Casing. 213.66' Pipe set @ 221.16 K.B. Cemented with 200 sacks regular cement with 3% c.c. and 2% gel. Plug down at 1:30 AM, 12-22-68.
30 - 45 Sand	
45 - 228 Shale	
228 - 3005 Lime and Shale	
3005 - 3070 Lime and Chert	
3070 - 3285 Lime	
3285 - 3354 Shale	
3354 - 3373 Lime	Plugged.

RECEIVED  
STATE CORPORATION COMMISSION  
FEB 26 1969  
CONSERVATION DIVISION  
Wichita, Kansas